


EQUIPMENT & PROCEDURES

EQUIPMENT: GR-3 TOPCON GPS ANTENNAE AND TOPCON PROCESSING SOFTWARE
 PROCEDURES: INITIAL CONTROL ESTABLISHED BY GPS STATIC OBSERVATIONS
 PROCEDURES MEET OR EXCEED W.A.C. 332-130-090.

BASIS OF BEARING


DERIVED FROM GPS STATIC OCCUPATIONS OF PROVIDED CONTROL MONUMENTATION,
 ALL DISTANCES ARE HEREIN GRID

OKANOGAN COUNTY ASSESSOR, STATE OF WASHINGTON PARCEL LAYER USE FOR PARCEL LINES.
 NO PROPERTY BOUNDARIES DETERMINED FOR THIS SURVEY.

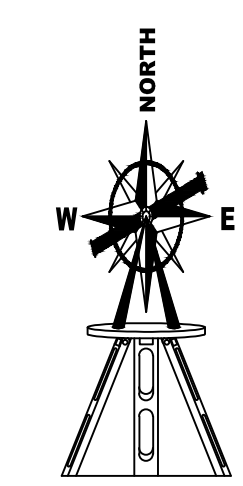

LEGEND

- IRRIGATION WATER VALVE
- IRRIGATION SERVICE
- AIR VAC ASSEMBLY
- IRRIGATION DRAIN ACCESS PANEL
- IRRIGATION LINE
- EASEMENT LINE

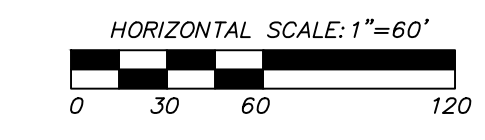

**RECORD OF SURVEY FOR
 M.V.I.D.**

	TACKMAN SURVEYING	
	LAND SURVEYING - CONSTRUCTION LAYOUT LAND DEVELOPMENT 1112 HWY. 20 P.O. BOX 631 WINTHROP, WA. 98862 PH. (509) 996.3409	
CLIENT: LLOYD LOGGING	DWG: WEST PIPELINE ASBULTS	
DATE: 03/18/2016	PROJECT: 15-111	
SCALE: 1"=60'		

SHT
 1
 OF
 6



EQUIPMENT & PROCEDURES

EQUIPMENT: GR-3 TOPCON GPS ANTENNAE AND TOPCON PROCESSING SOFTWARE
 PROCEDURES: INITIAL CONTROL ESTABLISHED BY GPS STATIC OBSERVATIONS
 PROCEDURES MEET OR EXCEED W.A.C. 332-130-090.

BASIS OF BEARING


DERIVED FROM GPS STATIC OCCUPATIONS OF PROVIDED CONTROL MONUMENTATION,
 ALL DISTANCES ARE HEREIN GRID

OKANOGAN COUNTY ASSESSOR, STATE OF WASHINGTON PARCEL LAYER USE FOR PARCEL LINES.
 NO PROPERTY BOUNDARIES DETERMINED FOR THIS SURVEY.




LEGEND

- IRRIGATION WATER VALVE
- IRRIGATION SERVICE
- AIR VAC ASSEMBLY
- IRRIGATION DRAIN ACCESS PANEL
- IRRIGATION LINE
- EASEMENT LINE

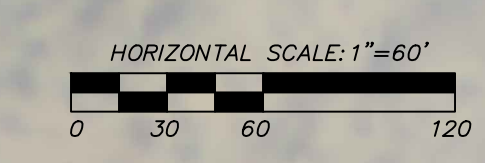

RECORD OF SURVEY FOR
M.V.I.D.

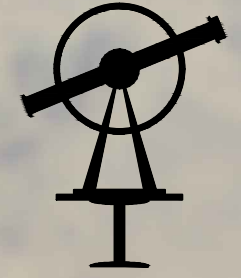	TACKMAN SURVEYING LAND SURVEYING - CONSTRUCTION LAYOUT LAND DEVELOPMENT 1112 HWY. 20 P.O. BOX 631 WINTHROP, WA. 98862 PH. (509) 996.3409	
	CLIENT: LLOYD LOGGING DATE: 03/18/2016 SCALE: 1"=60'	DWG: WEST PIPELINE ASBULTS PROJECT: 15-111

SHT
 1
 OF
 6




EQUIPMENT & PROCEDURES

EQUIPMENT: GR-3 TOPCON GPS ANTENNAE AND TOPCON PROCESSING SOFTWARE
 PROCEDURES: INITIAL CONTROL ESTABLISHED BY GPS STATIC OBSERVATIONS
 PROCEDURES MEET OR EXCEED W.A.C. 332-130-090.

BASIS OF BEARING

DERIVED FROM GPS STATIC OCCUPATIONS OF PROVIDED CONTROL MONUMENTATION.
 ALL DISTANCES ARE HEREIN GRID

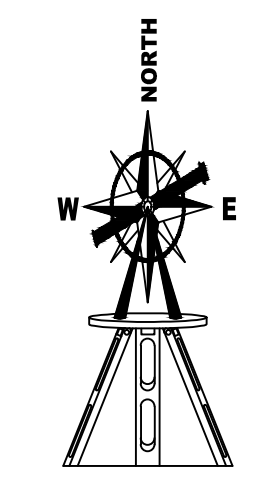

LEGEND

- IRRIGATION WATER VALVE
- IRRIGATION SERVICE
- AIR VAC ASSEMBLY
- IRRIGATION DRAIN ACCESS PANEL
- IRRIGATION LINE
- EASEMENT LINE



**RECORD OF SURVEY
 FOR
 M.V.I.D.**

TACKMAN SURVEYING
 LAND SURVEYING - CONSTRUCTION LAYOUT
 LAND DEVELOPMENT
 1112 HWY. 20
 P.O. BOX 631 WINTHROP, WA. 98862
 PH. (509) 996.3409

CLIENT: LLOYD LOGGING	DWG: WEST PIPELINE ASBUILTS
DATE: 03/18/2016	PROJECT: 15-111
SCALE: 1"=60'	

SHT
 2
 OF
 6




EQUIPMENT & PROCEDURES

EQUIPMENT: GR-3 TOPCON GPS ANTENNAE AND TOPCON PROCESSING SOFTWARE
 PROCEDURES: INITIAL CONTROL ESTABLISHED BY GPS STATIC OBSERVATIONS
 PROCEDURES MEET OR EXCEED W.A.C. 332-130-090.


BASIS OF BEARING

DERIVED FROM GPS STATIC OCCUPATIONS OF PROVIDED CONTROL MONUMENTATION.
 ALL DISTANCES ARE HEREIN GRID

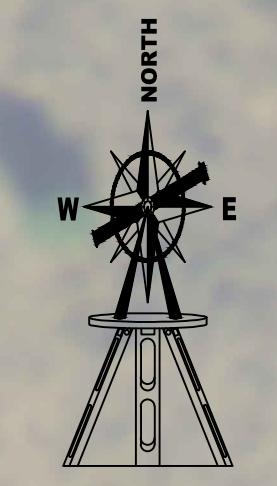


LEGEND

- IRRIGATION WATER VALVE
- IRRIGATION SERVICE
- AIR VAC ASSEMBLY
- IRRIGATION DRAIN ACCESS PANEL
- IRRIGATION LINE
- EASEMENT LINE

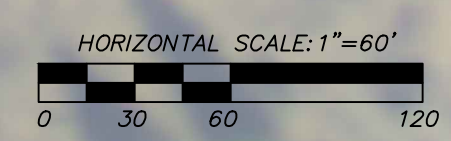

**RECORD OF SURVEY
 FOR
 M.V.I.D.**

	TACKMAN SURVEYING LAND SURVEYING - CONSTRUCTION LAYOUT LAND DEVELOPMENT 1112 HWY. 20 P.O. BOX 631 WINTHROP, WA. 98862 PH. (509) 996.3409		SHT 2 OF 6
	CLIENT: LLOYD LOGGING DATE: 03/18/2016 SCALE: 1"=60'	DWG: WEST PIPELINE ASBUILTS PROJECT: 15-111	

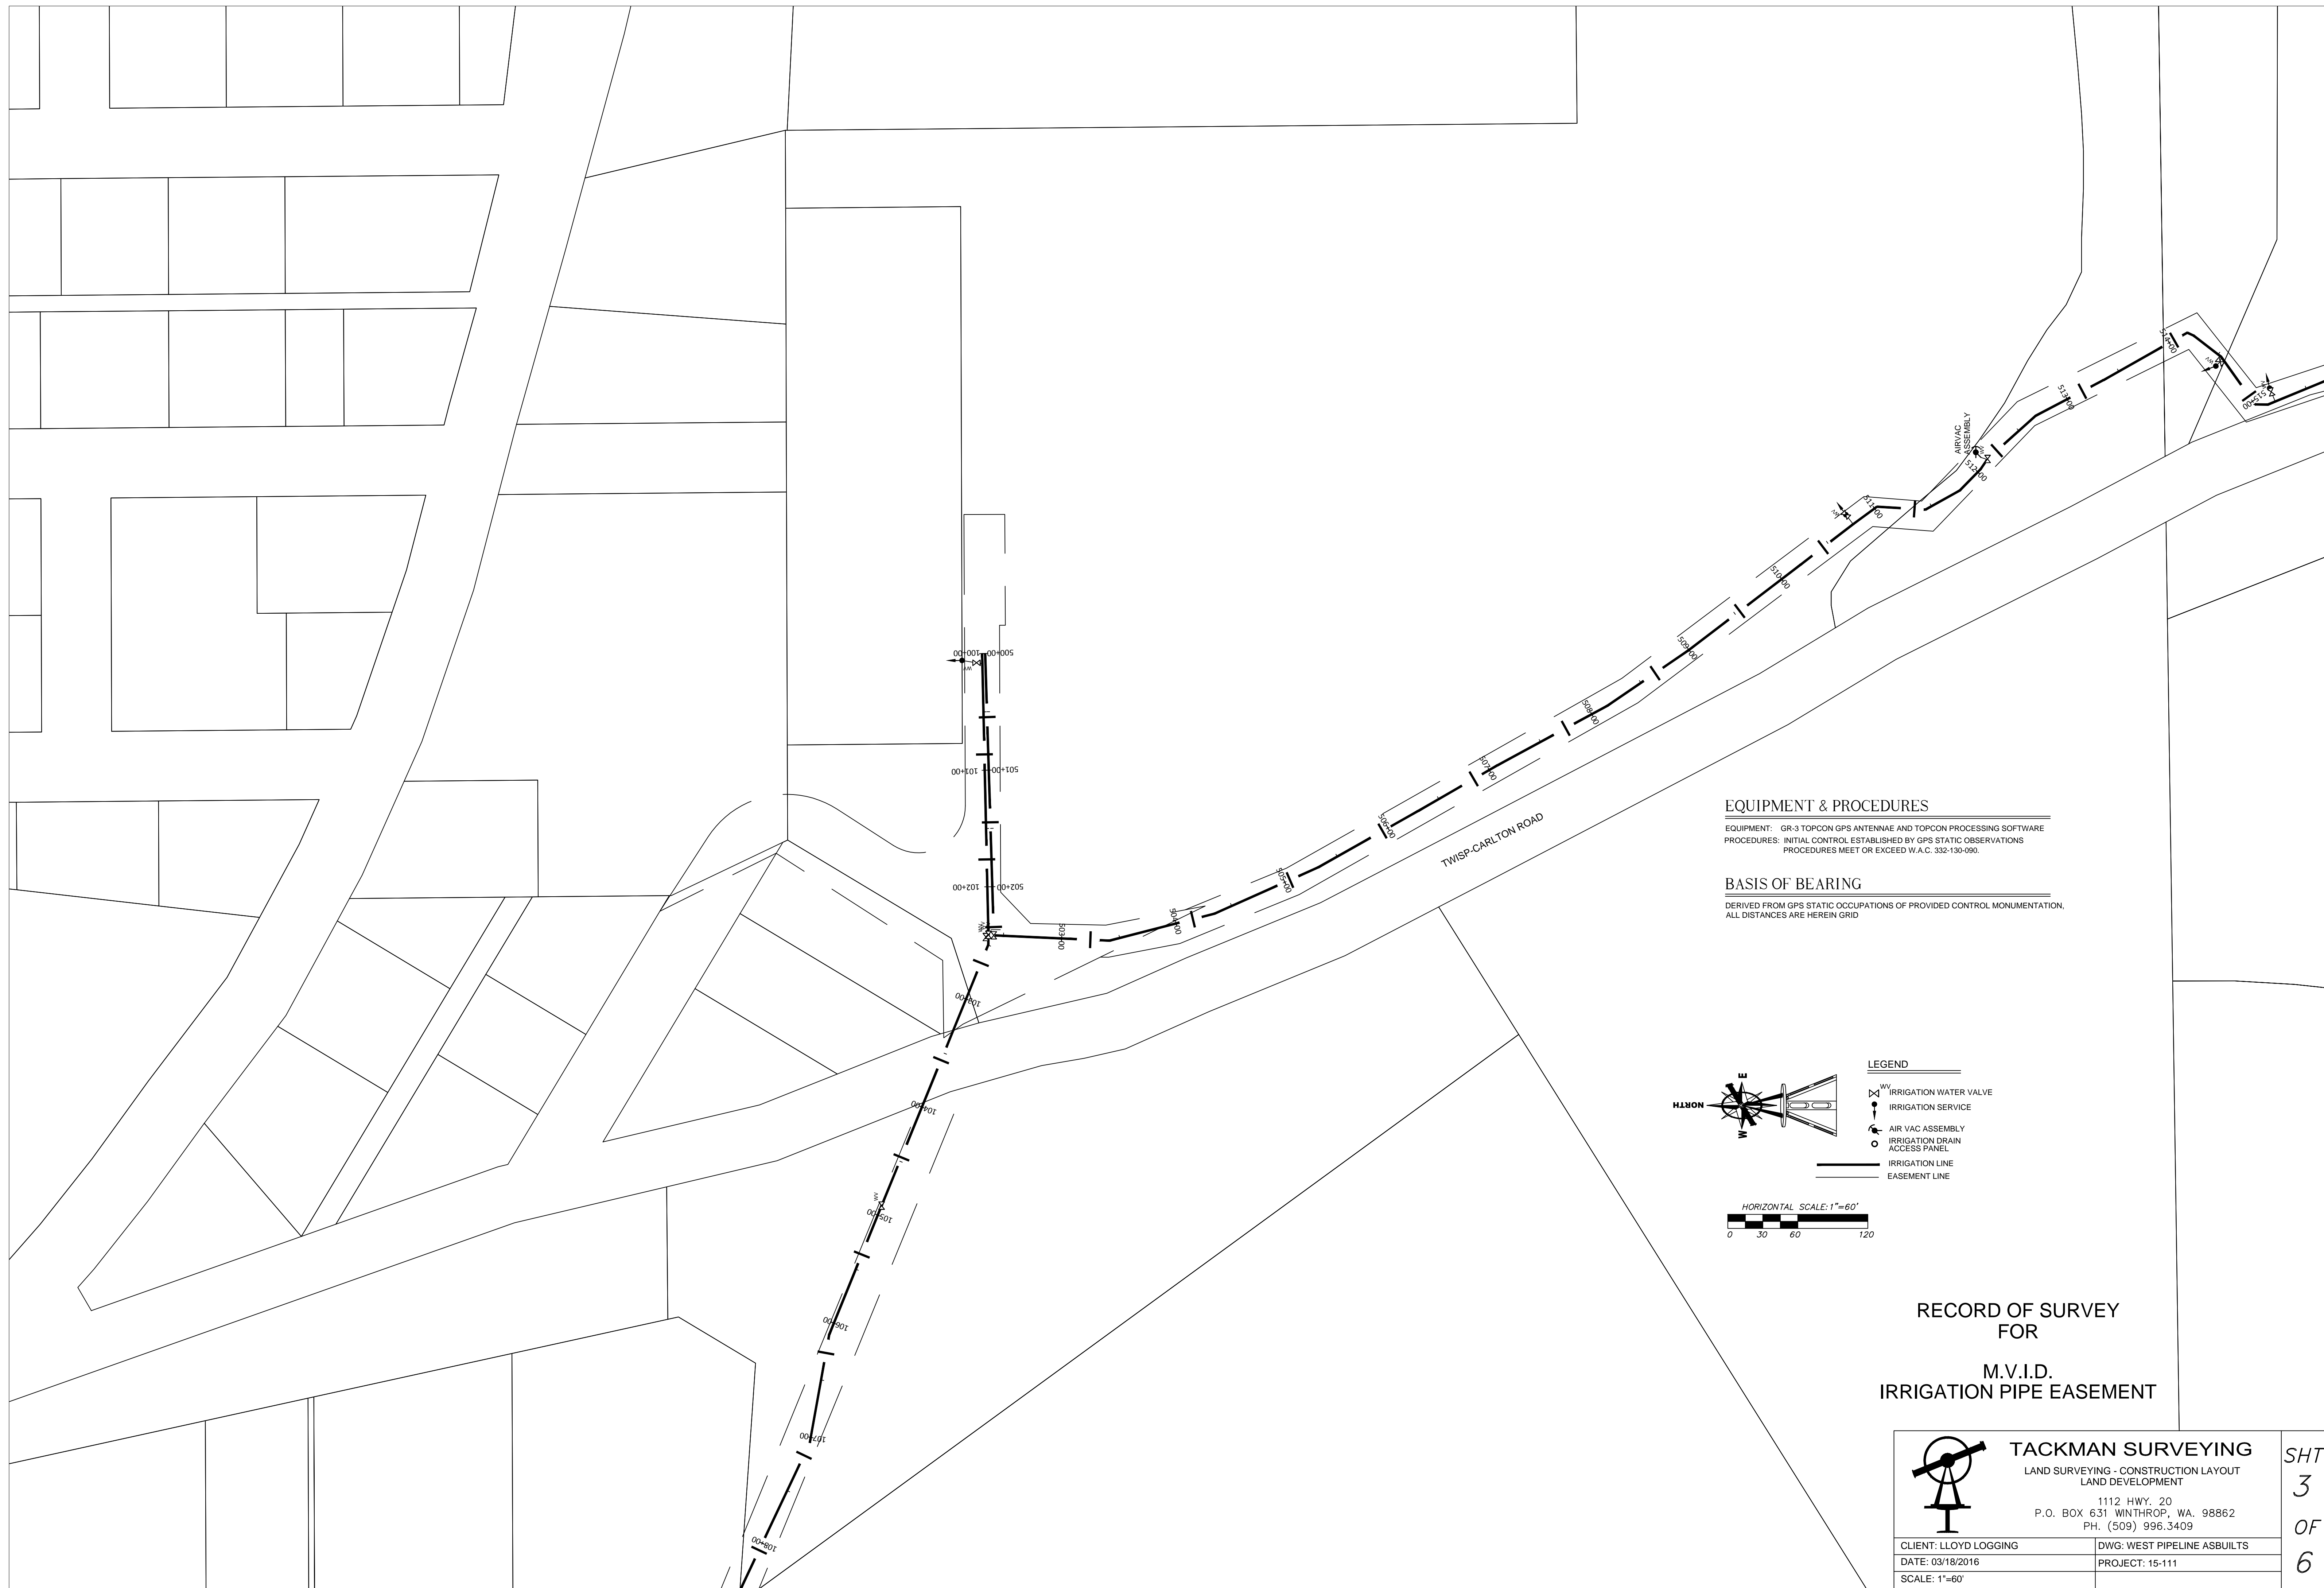


EQUIPMENT & PROCEDURES
 EQUIPMENT: GR-3 TOPCON GPS ANTENNAE AND TOPCON PROCESSING SOFTWARE
 PROCEDURES: INITIAL CONTROL ESTABLISHED BY GPS STATIC OBSERVATIONS
 PROCEDURES MEET OR EXCEED W.A.C. 332-130-090.

BASIS OF BEARING
 DERIVED FROM GPS STATIC OCCUPATIONS OF PROVIDED CONTROL MONUMENTATION.
 ALL DISTANCES ARE HEREIN GRID

LEGEND


- IRRIGATION WATER VALVE
- IRRIGATION SERVICE
- AIR VAC ASSEMBLY
- IRRIGATION DRAIN ACCESS PANEL
- IRRIGATION LINE
- EASEMENT LINE

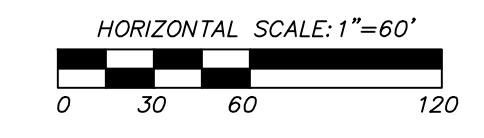

**RECORD OF SURVEY
 FOR
 M.V.I.D.
 IRRIGATION PIPE EASEMENT**

	TACKMAN SURVEYING	
	LAND SURVEYING - CONSTRUCTION LAYOUT LAND DEVELOPMENT	
	1112 HWY. 20 P.O. BOX 631 WINTHROP, WA. 98862 PH. (509) 996.3409	
CLIENT: LLOYD LOGGING	DWG: WEST PIPELINE ASBUILTS	
DATE: 03/18/2016	PROJECT: 15-111	
SCALE: 1"=60'		

SHT
 3
 OF
 6

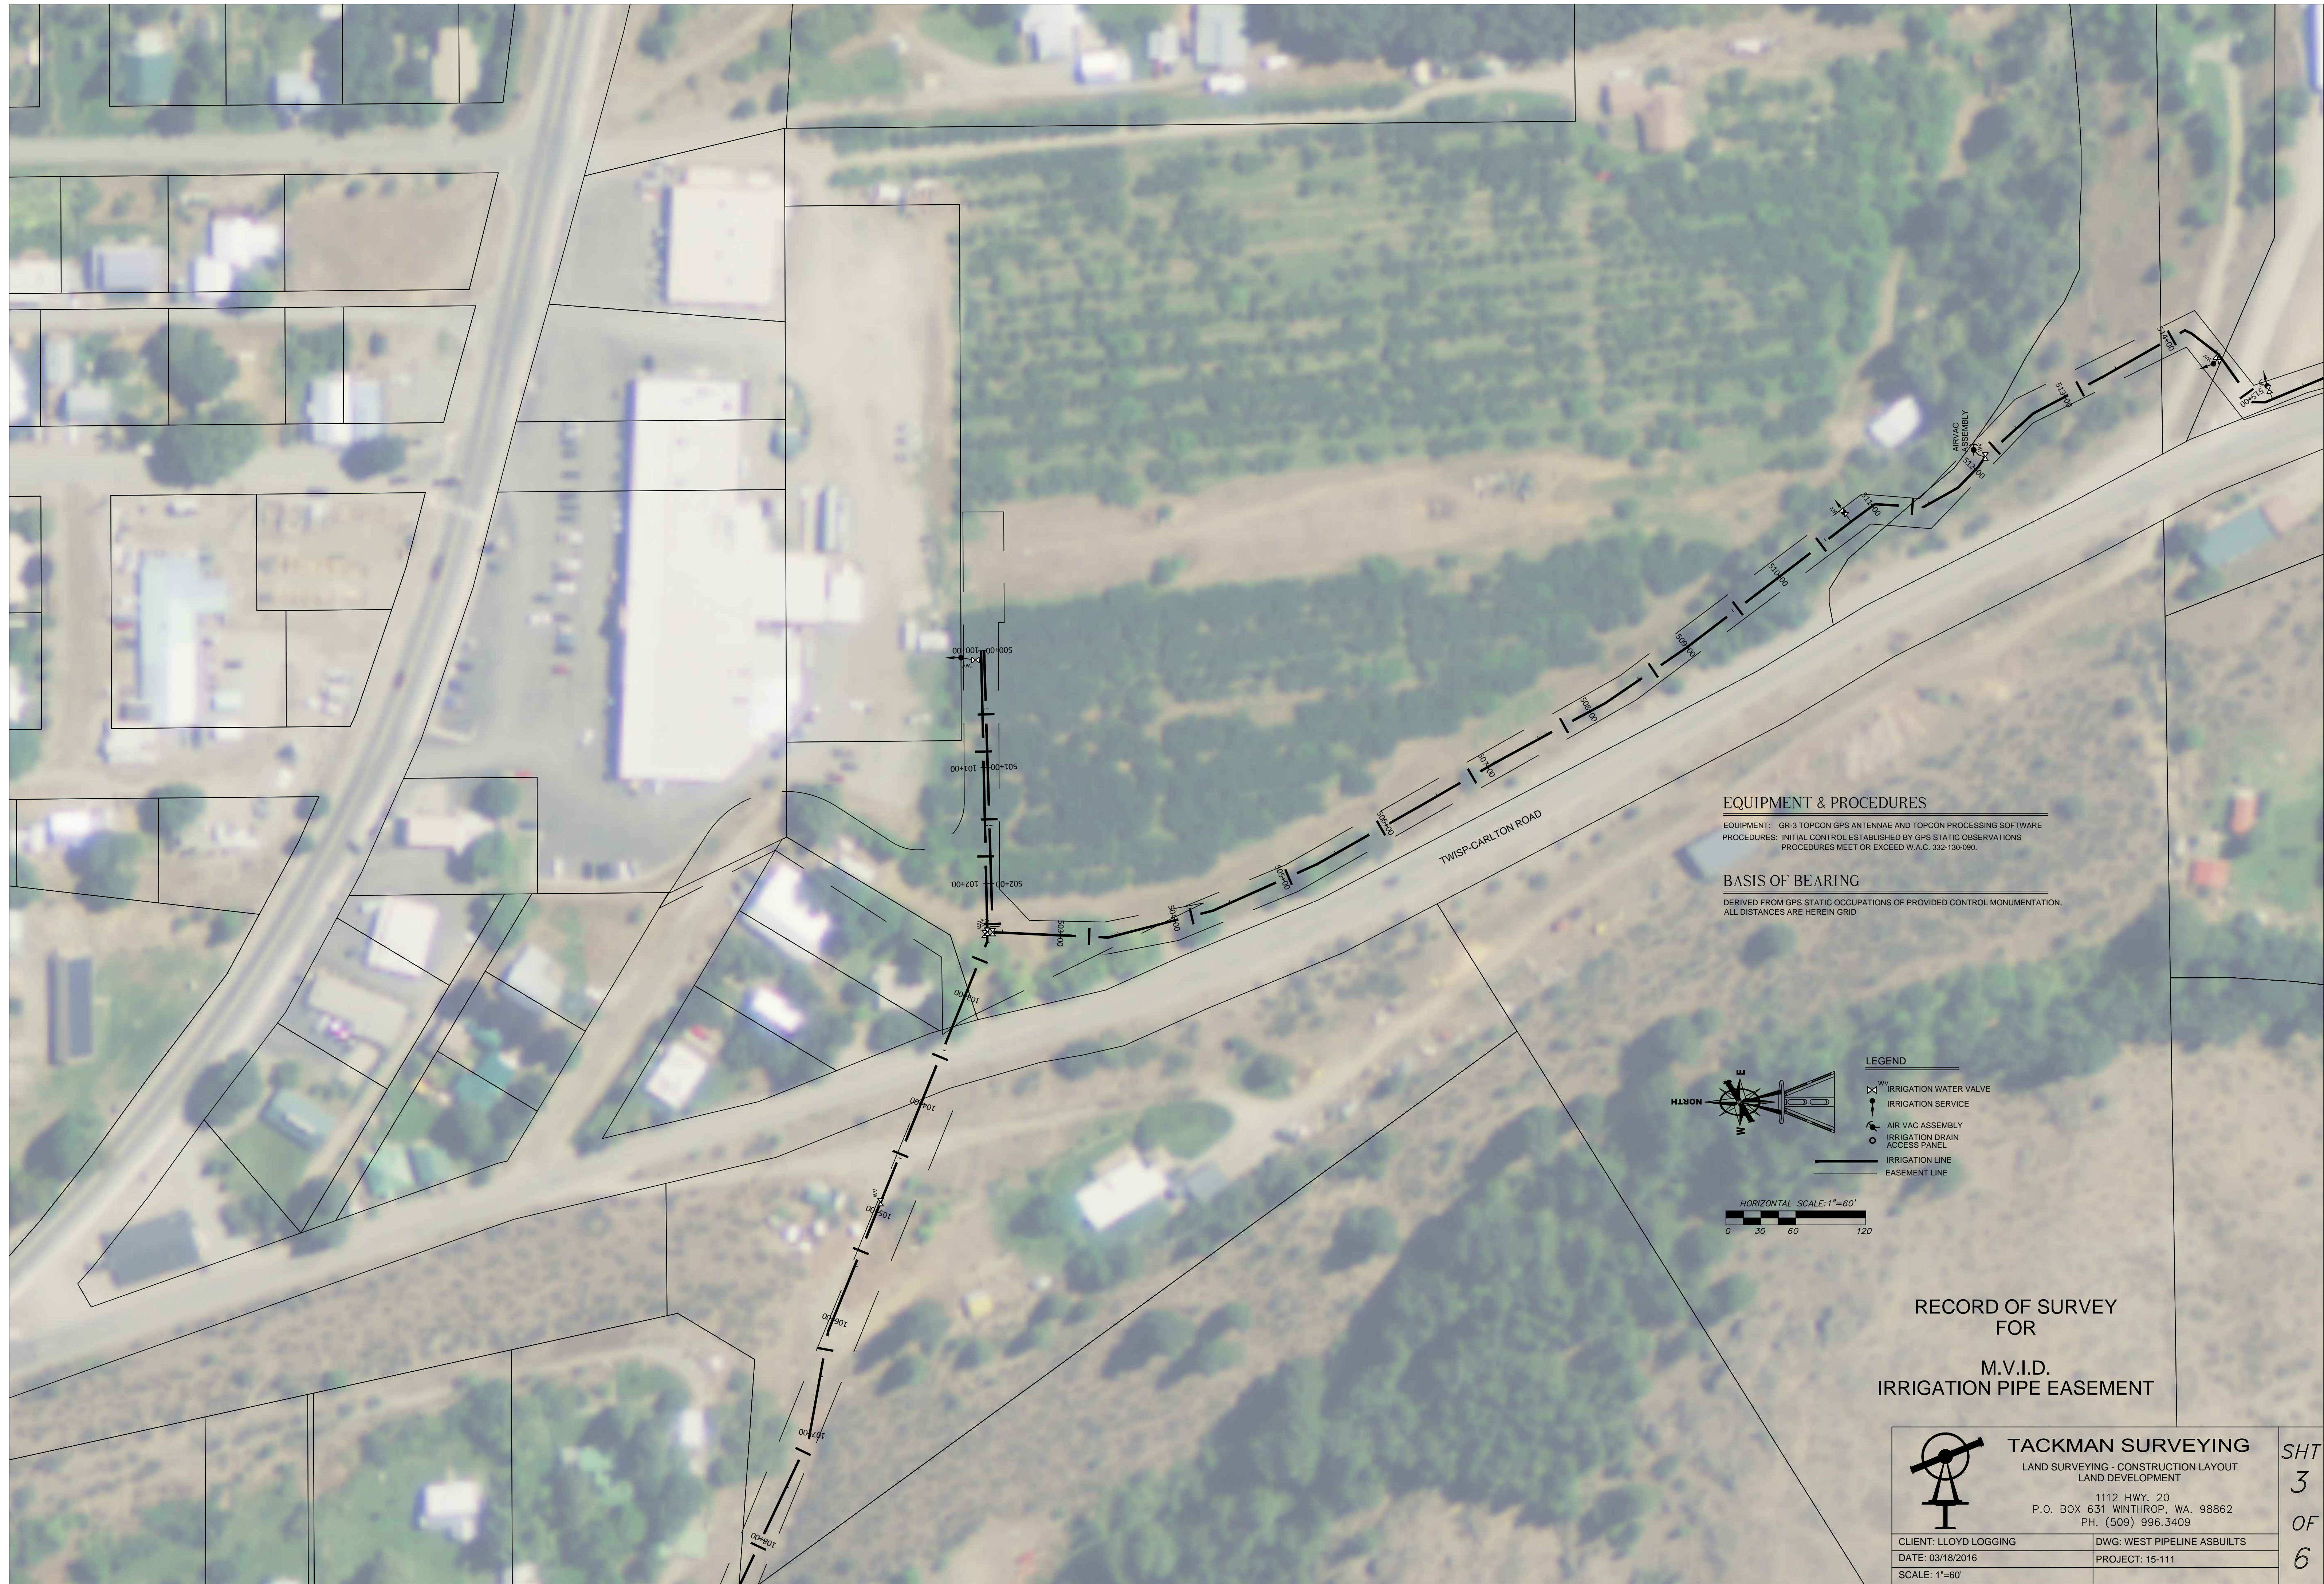

EQUIPMENT & PROCEDURES
 EQUIPMENT: GR-3 TOPCON GPS ANTENNAE AND TOPCON PROCESSING SOFTWARE
 PROCEDURES: INITIAL CONTROL ESTABLISHED BY GPS STATIC OBSERVATIONS
 PROCEDURES MEET OR EXCEED W.A.C. 332-130-090.

BASIS OF BEARING
 DERIVED FROM GPS STATIC OCCUPATIONS OF PROVIDED CONTROL MONUMENTATION,
 ALL DISTANCES ARE HEREIN GRID


LEGEND

- WV IRRIGATION WATER VALVE
- IRRIGATION SERVICE
- AIR VAC ASSEMBLY
- IRRIGATION DRAIN ACCESS PANEL
- IRRIGATION LINE
- EASEMENT LINE

HORIZONTAL SCALE: 1"=60'

RECORD OF SURVEY FOR
M.V.I.D.
IRRIGATION PIPE EASEMENT

	TACKMAN SURVEYING LAND SURVEYING - CONSTRUCTION LAYOUT LAND DEVELOPMENT		SHT 3 OF 6
	1112 HWY. 20 P.O. BOX 631 WINTHROP, WA. 98862 PH. (509) 996.3409		
CLIENT: LLOYD LOGGING DATE: 03/18/2016 SCALE: 1"=60'	DWG: WEST PIPELINE ASBUILTS PROJECT: 15-111		

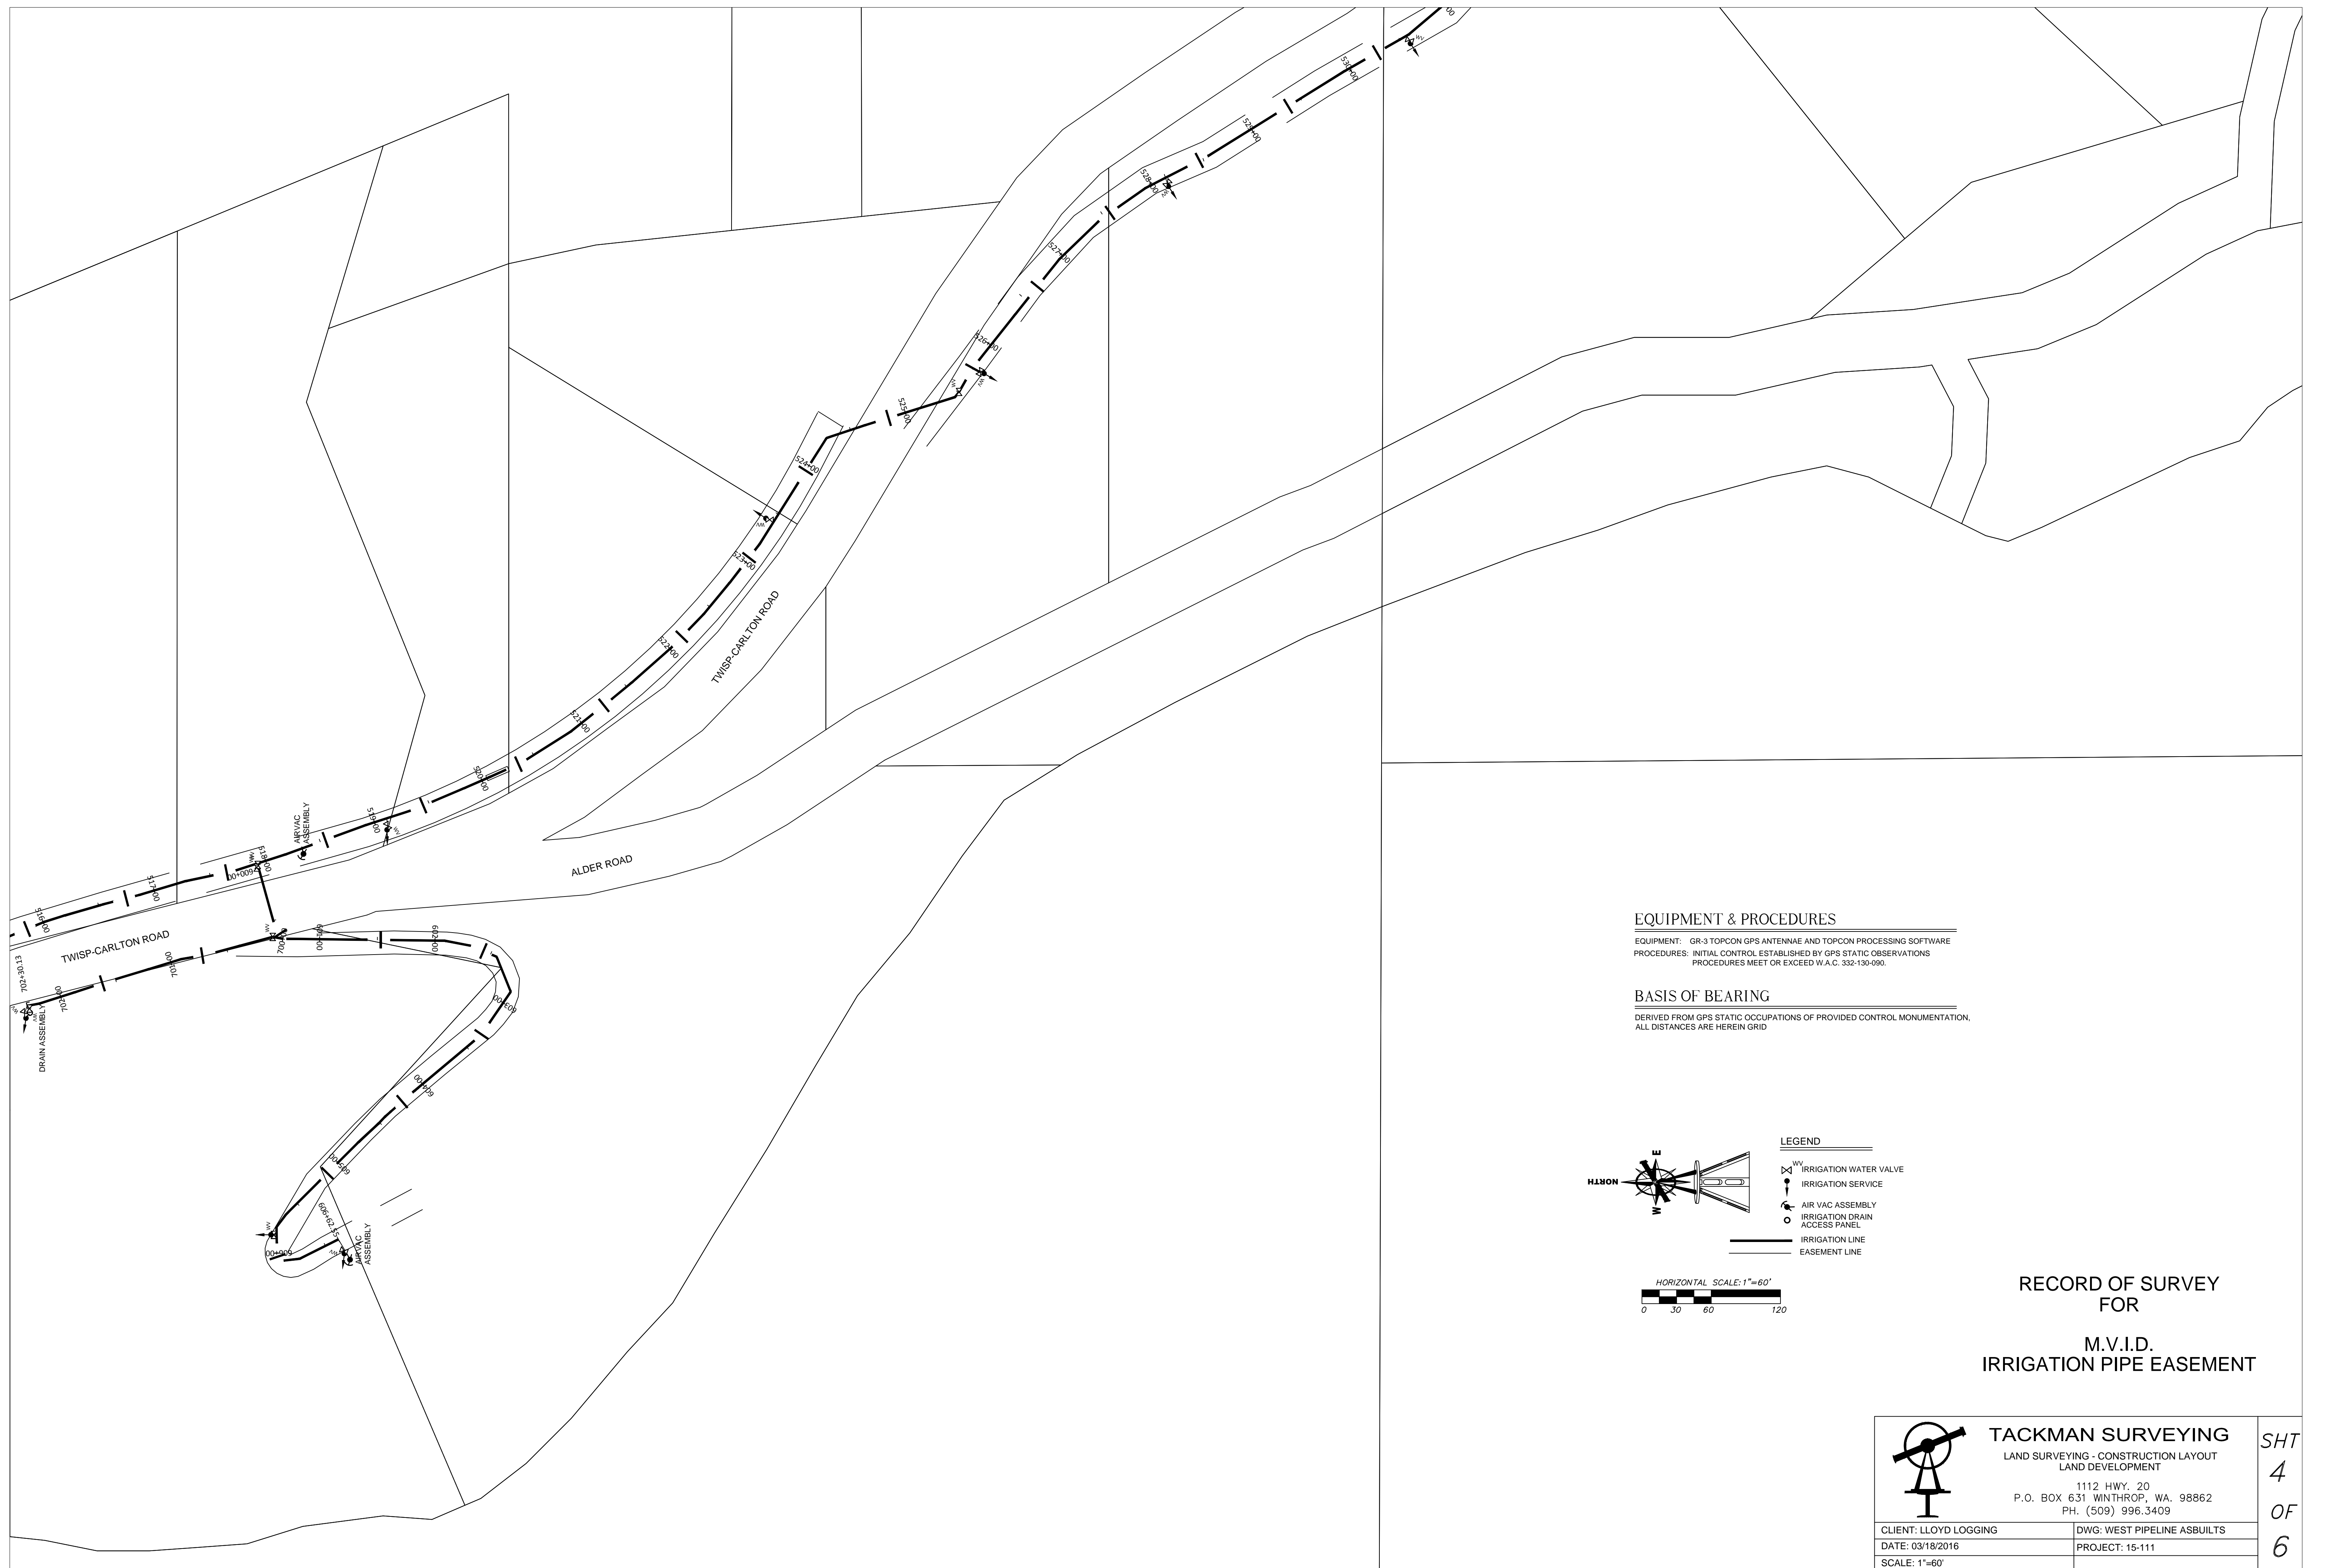


EQUIPMENT & PROCEDURES


EQUIPMENT: GR-3 TOPCON GPS ANTENNAE AND TOPCON PROCESSING SOFTWARE
 PROCEDURES: INITIAL CONTROL ESTABLISHED BY GPS STATIC OBSERVATIONS
 PROCEDURES MEET OR EXCEED W.A.C. 332-130-090.

BASIS OF BEARING

DERIVED FROM GPS STATIC OCCUPATIONS OF PROVIDED CONTROL MONUMENTATION,
 ALL DISTANCES ARE HEREIN GRID

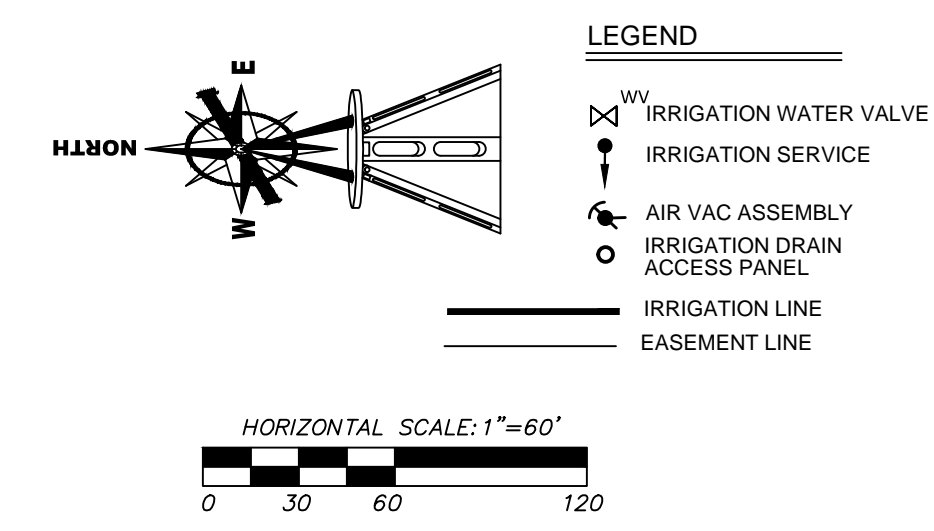

**RECORD OF SURVEY
 FOR
 M.V.I.D.
 IRRIGATION PIPE EASEMENT**

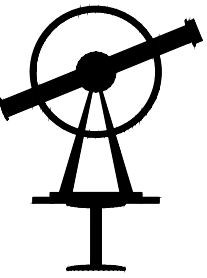 TACKMAN SURVEYING LAND SURVEYING - CONSTRUCTION LAYOUT LAND DEVELOPMENT 1112 HWY. 20 P.O. BOX 631 WINTHROP, WA. 98862 PH. (509) 996.3409	SHT
	4
CLIENT: LLOYD LOGGING DATE: 03/18/2016 SCALE: 1"=60'	OF
DWG: WEST PIPELINE ASBUILTS PROJECT: 15-111	6




EQUIPMENT & PROCEDURES


EQUIPMENT: GR-3 TOPCON GPS ANTENNAE AND TOPCON PROCESSING SOFTWARE
 PROCEDURES: INITIAL CONTROL ESTABLISHED BY GPS STATIC OBSERVATIONS
 PROCEDURES MEET OR EXCEED W.A.C. 332-130-090.


BASIS OF BEARING

DERIVED FROM GPS STATIC OCCUPATIONS OF PROVIDED CONTROL MONUMENTATION,
 ALL DISTANCES ARE HEREIN GRID

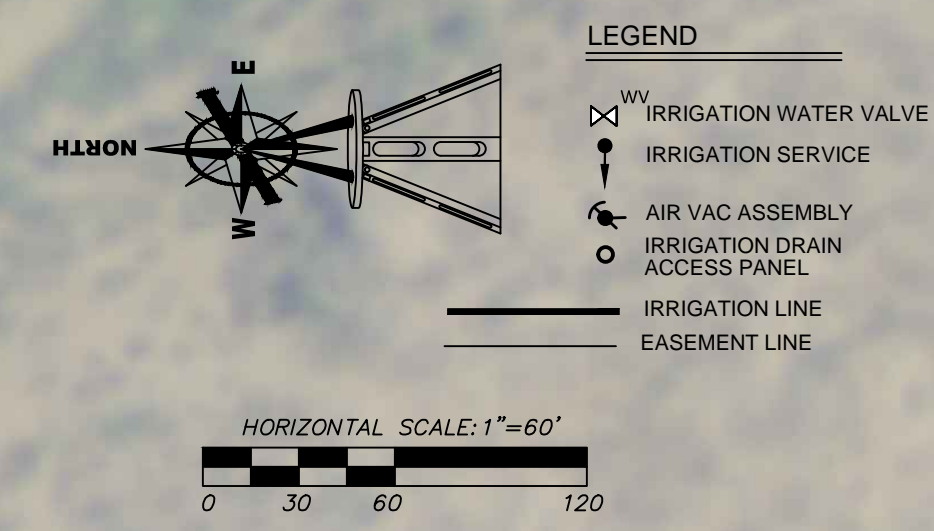


**RECORD OF SURVEY
 FOR
 M.V.I.D.
 IRRIGATION PIPE EASEMENT**

	TACKMAN SURVEYING LAND SURVEYING - CONSTRUCTION LAYOUT LAND DEVELOPMENT		SHT 4 OF 6
	1112 HWY. 20 P.O. BOX 631 WINTHROP, WA. 98862 PH. (509) 996.3409		
CLIENT: LLOYD LOGGING	DWG: WEST PIPELINE ASBUILTS		
DATE: 03/18/2016	PROJECT: 15-111		
SCALE: 1"=60'			

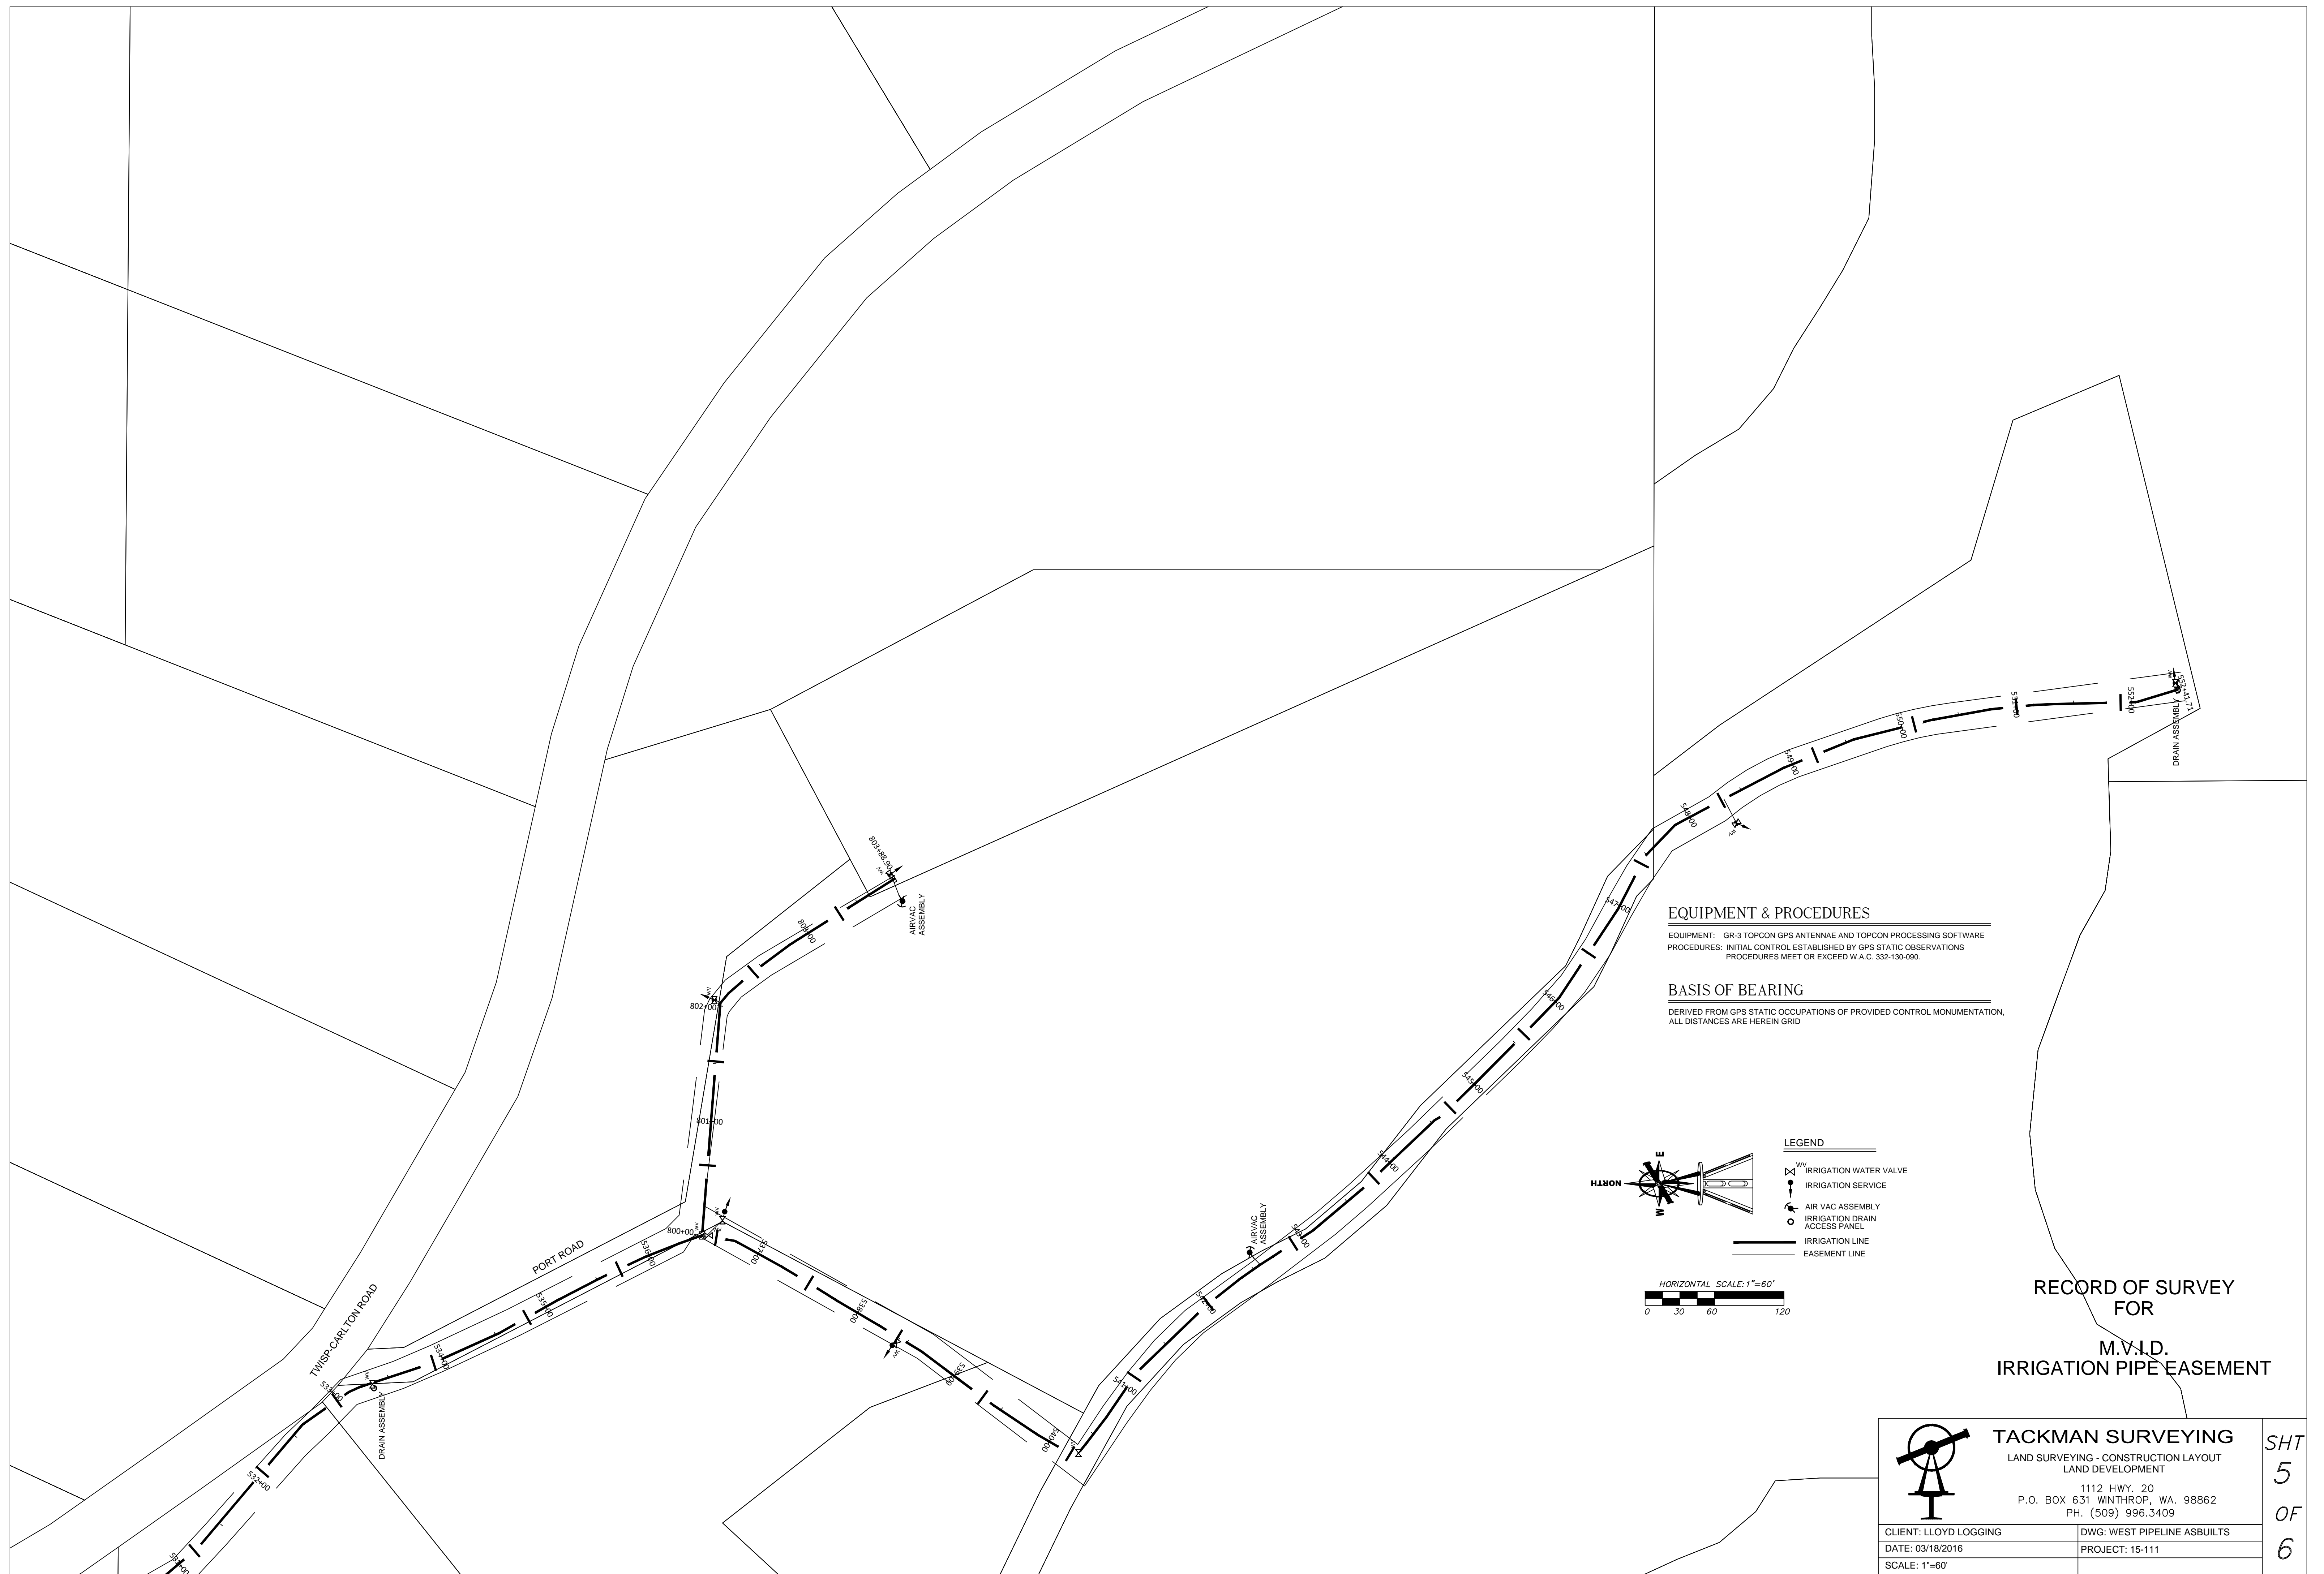


EQUIPMENT & PROCEDURES
 EQUIPMENT: GR-3 TOPCON GPS ANTENNAE AND TOPCON PROCESSING SOFTWARE
 PROCEDURES: INITIAL CONTROL ESTABLISHED BY GPS STATIC OBSERVATIONS
 PROCEDURES MEET OR EXCEED W.A.C. 332-130-090.

BASIS OF BEARING
 DERIVED FROM GPS STATIC OCCUPATIONS OF PROVIDED CONTROL MONUMENTATION.
 ALL DISTANCES ARE HEREIN GRID

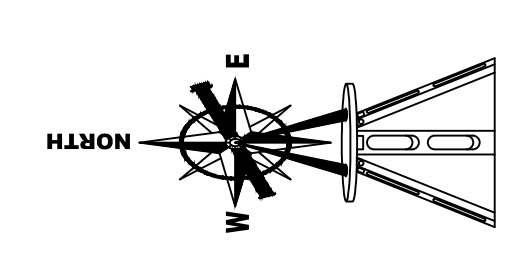

- LEGEND**
- IRRIGATION WATER VALVE
 - IRRIGATION SERVICE
 - AIR VAC ASSEMBLY
 - IRRIGATION DRAIN ACCESS PANEL
 - IRRIGATION LINE
 - EASEMENT LINE

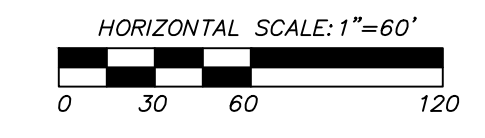

RECORD OF SURVEY FOR
 M.V.I.D.
 IRRIGATION PIPE EASEMENT


	TACKMAN SURVEYING	
	LAND SURVEYING - CONSTRUCTION LAYOUT LAND DEVELOPMENT	
	1112 HWY. 20 P.O. BOX 631 WINTHROP, WA 98862 PH. (509) 996.3409	
	CLIENT: LLOYD LOGGING	DWG: WEST PIPELINE ASBUILTS
DATE: 03/18/2016	PROJECT: 15-111	
SCALE: 1"=60'		

SHT
 5
 OF
 6




EQUIPMENT & PROCEDURES
 EQUIPMENT: GR-3 TOPCON GPS ANTENNAE AND TOPCON PROCESSING SOFTWARE
 PROCEDURES: INITIAL CONTROL ESTABLISHED BY GPS STATIC OBSERVATIONS
 PROCEDURES MEET OR EXCEED W.A.C. 332-130-090.

BASIS OF BEARING
 DERIVED FROM GPS STATIC OCCUPATIONS OF PROVIDED CONTROL MONUMENTATION.
 ALL DISTANCES ARE HEREIN GRID

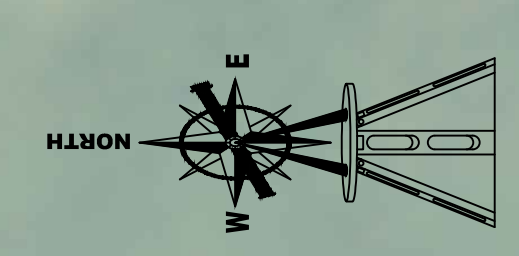


- LEGEND**
- IRRIGATION WATER VALVE
 - IRRIGATION SERVICE
 - AIR VAC ASSEMBLY
 - IRRIGATION DRAIN ACCESS PANEL
 - IRRIGATION LINE
 - EASEMENT LINE

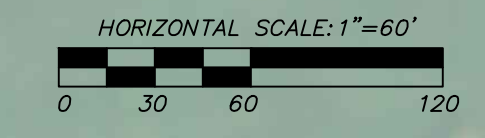

**RECORD OF SURVEY FOR
 M.V.I.D.
 IRRIGATION PIPE EASEMENT**

	TACKMAN SURVEYING	
	LAND SURVEYING - CONSTRUCTION LAYOUT LAND DEVELOPMENT	
	1112 HWY. 20 P.O. BOX 631 WINTHROP, WA 98862 PH. (509) 996.3409	
CLIENT: LLOYD LOGGING	DWG: WEST PIPELINE ASBUILTS	
DATE: 03/18/2016	PROJECT: 15-111	
SCALE: 1"=60'		

SHT
5
OF
6

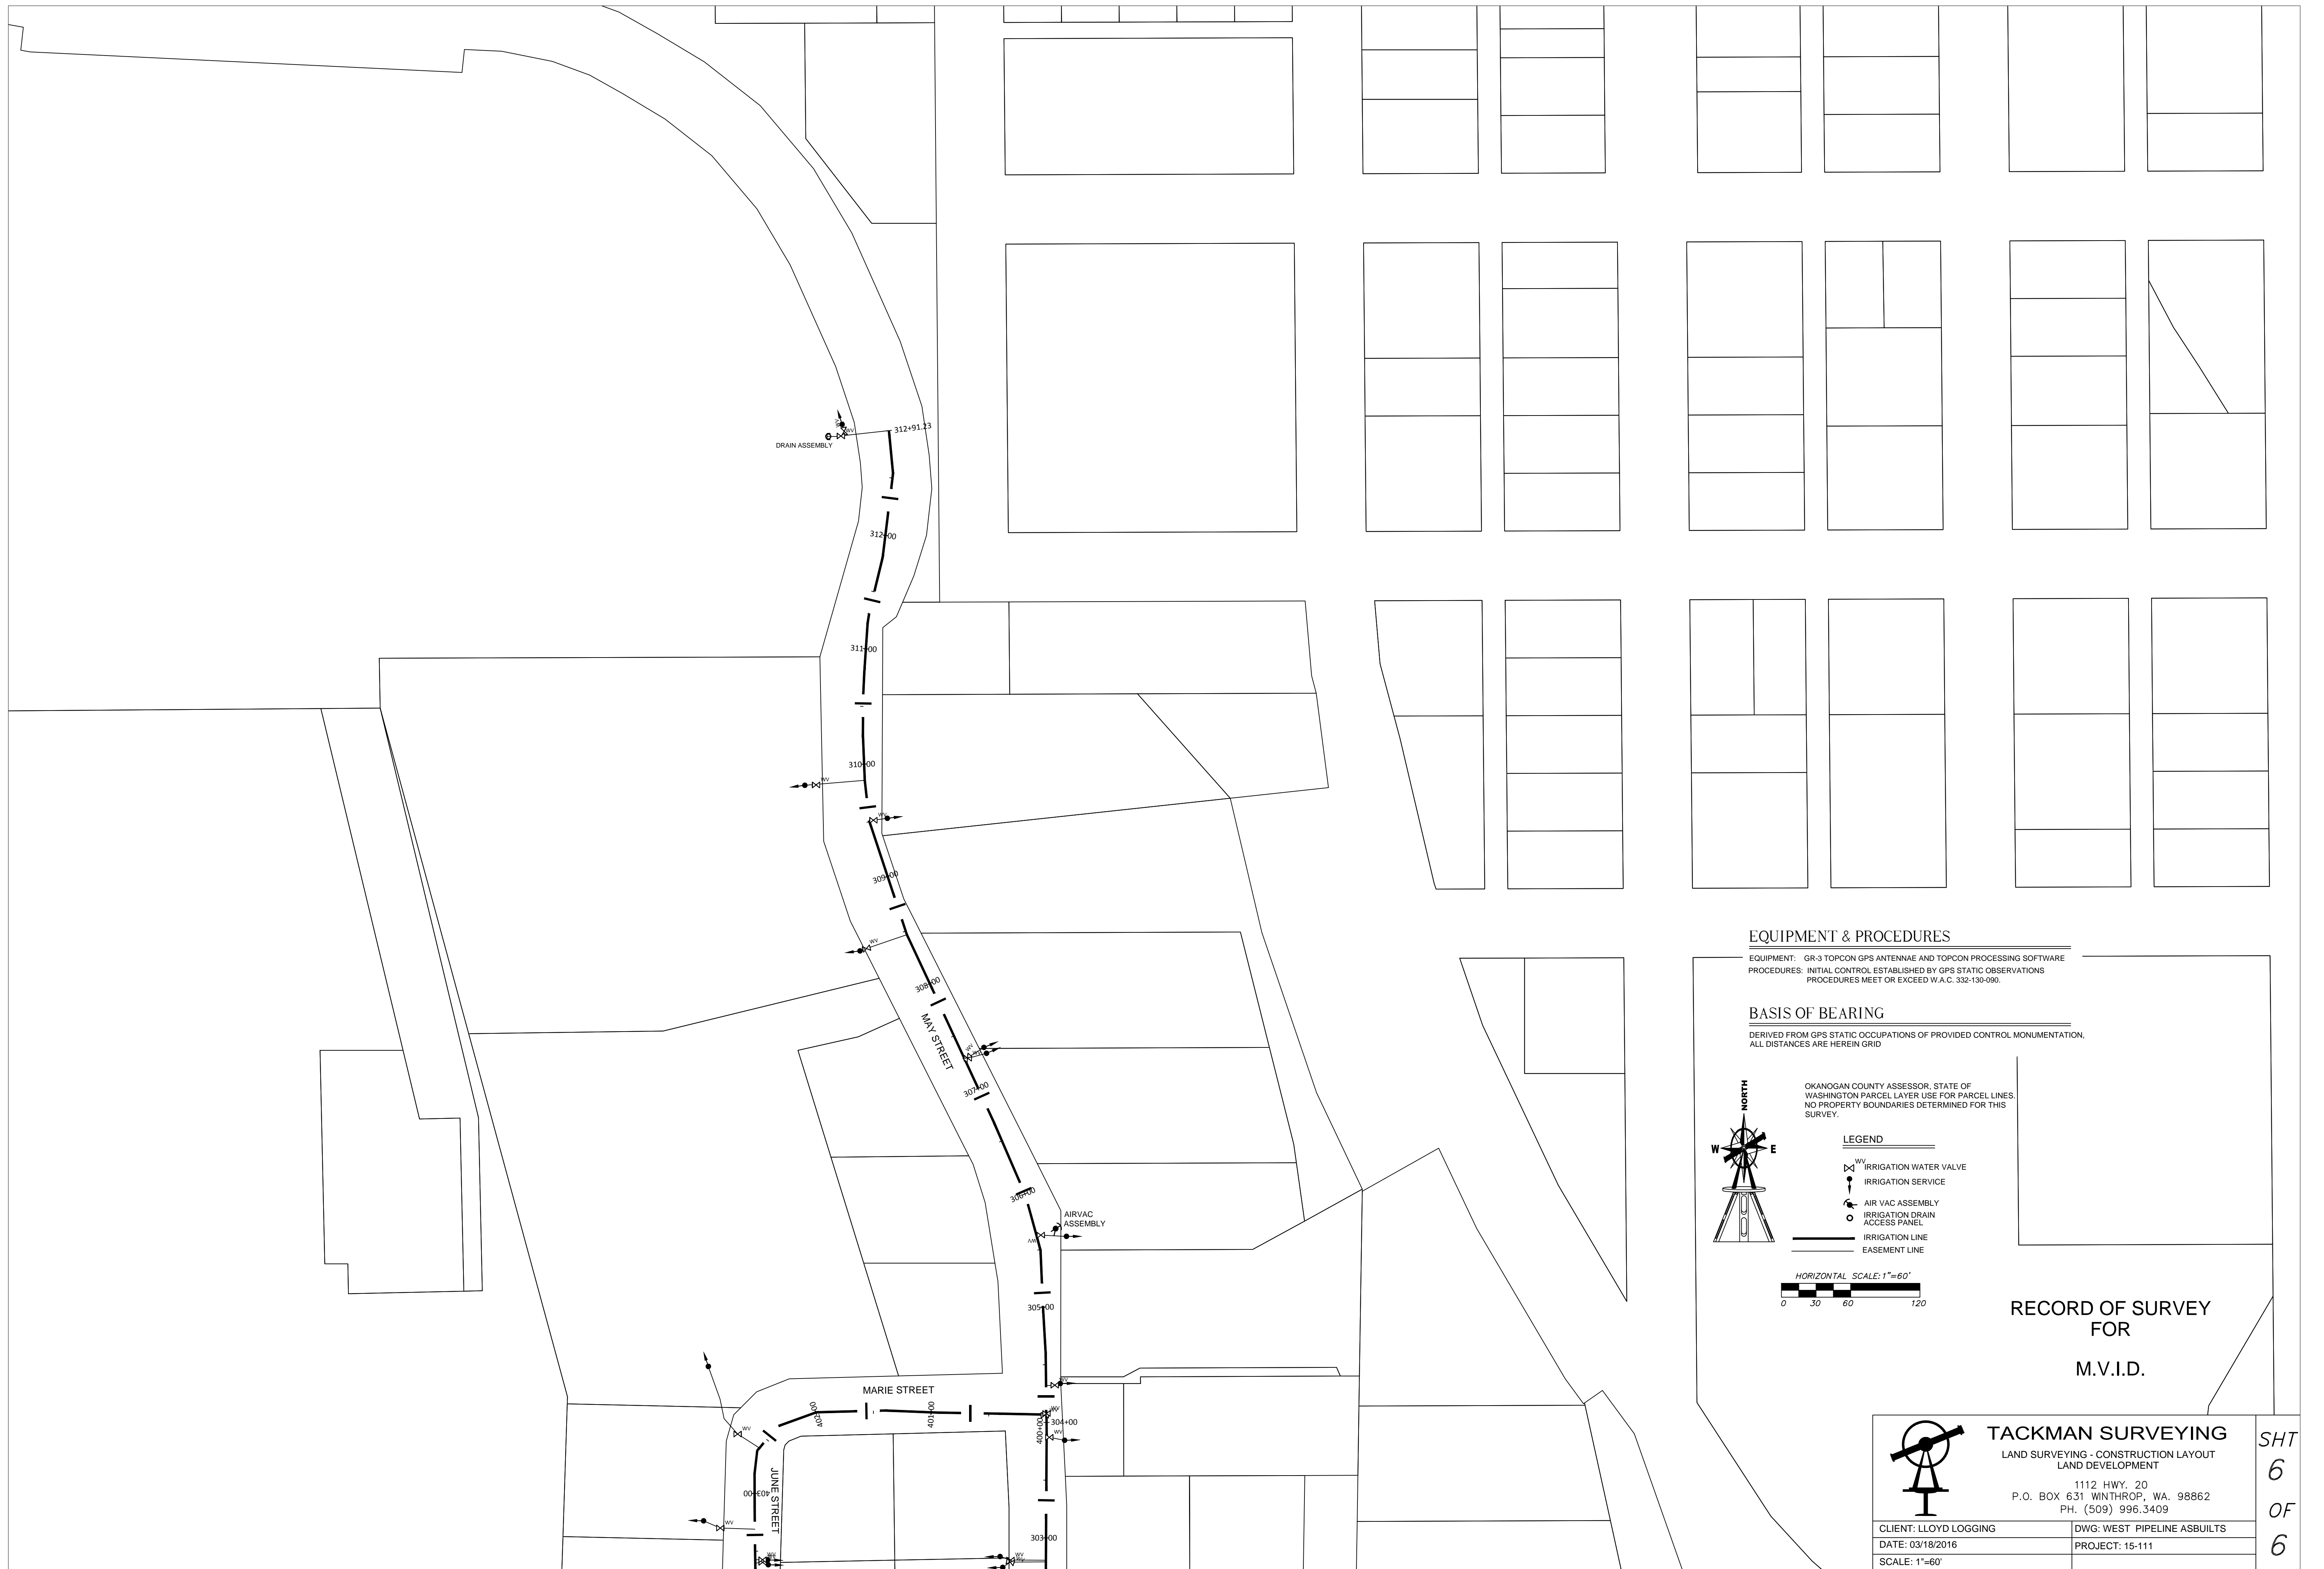


EQUIPMENT & PROCEDURES

EQUIPMENT: GR-3 TOPCON GPS ANTENNAE AND TOPCON PROCESSING SOFTWARE
 PROCEDURES: INITIAL CONTROL ESTABLISHED BY GPS STATIC OBSERVATIONS
 PROCEDURES MEET OR EXCEED W.A.C. 332-130-090.

BASIS OF BEARING

DERIVED FROM GPS STATIC OCCUPATIONS OF PROVIDED CONTROL MONUMENTATION.
 ALL DISTANCES ARE HEREIN GRID

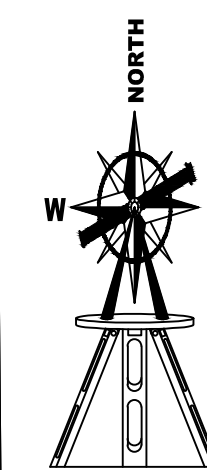


OKANOGAN COUNTY ASSESSOR, STATE OF WASHINGTON PARCEL LAYER USE FOR PARCEL LINES. NO PROPERTY BOUNDARIES DETERMINED FOR THIS SURVEY.

LEGEND

- IRRIGATION WATER VALVE
- IRRIGATION SERVICE
- AIR VAC ASSEMBLY
- IRRIGATION DRAIN ACCESS PANEL
- IRRIGATION LINE
- EASEMENT LINE



RECORD OF SURVEY FOR
M.V.I.D.

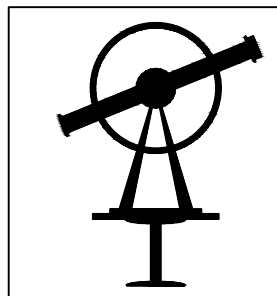

TACKMAN SURVEYING
 LAND SURVEYING - CONSTRUCTION LAYOUT
 LAND DEVELOPMENT

1112 HWY. 20
 P.O. BOX 631 WINTHROP, WA. 98862
 PH. (509) 996.3409

CLIENT: LLOYD LOGGING
 DATE: 03/18/2016
 SCALE: 1"=60'

DWG: WEST PIPELINE ASBUILTS
 PROJECT: 15-111

SHT
 6
 OF
 6



EQUIPMENT & PROCEDURES

EQUIPMENT: GR-3 TOPCON GPS ANTENNAE AND TOPCON PROCESSING SOFTWARE
 PROCEDURES: INITIAL CONTROL ESTABLISHED BY GPS STATIC OBSERVATIONS
 PROCEDURES MEET OR EXCEED W.A.C. 332-130-090.

BASIS OF BEARING


DERIVED FROM GPS STATIC OCCUPATIONS OF PROVIDED CONTROL MONUMENTATION,
 ALL DISTANCES ARE HEREIN GRID



OKANOGAN COUNTY ASSESSOR, STATE OF WASHINGTON PARCEL LAYER USE FOR PARCEL LINES. NO PROPERTY BOUNDARIES DETERMINED FOR THIS SURVEY.

LEGEND

- IRRIGATION WATER VALVE
- IRRIGATION SERVICE
- AIR VAC ASSEMBLY
- IRRIGATION DRAIN ACCESS PANEL
- IRRIGATION LINE
- EASEMENT LINE

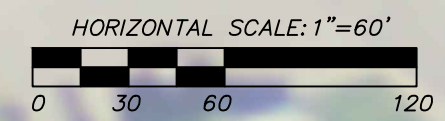

RECORD OF SURVEY FOR M.V.I.D.

TACKMAN SURVEYING LAND SURVEYING - CONSTRUCTION LAYOUT LAND DEVELOPMENT 1112 HWY. 20 P.O. BOX 631 WINTHROP, WA. 98862 PH. (509) 996.3409		SHT 6 OF 6