

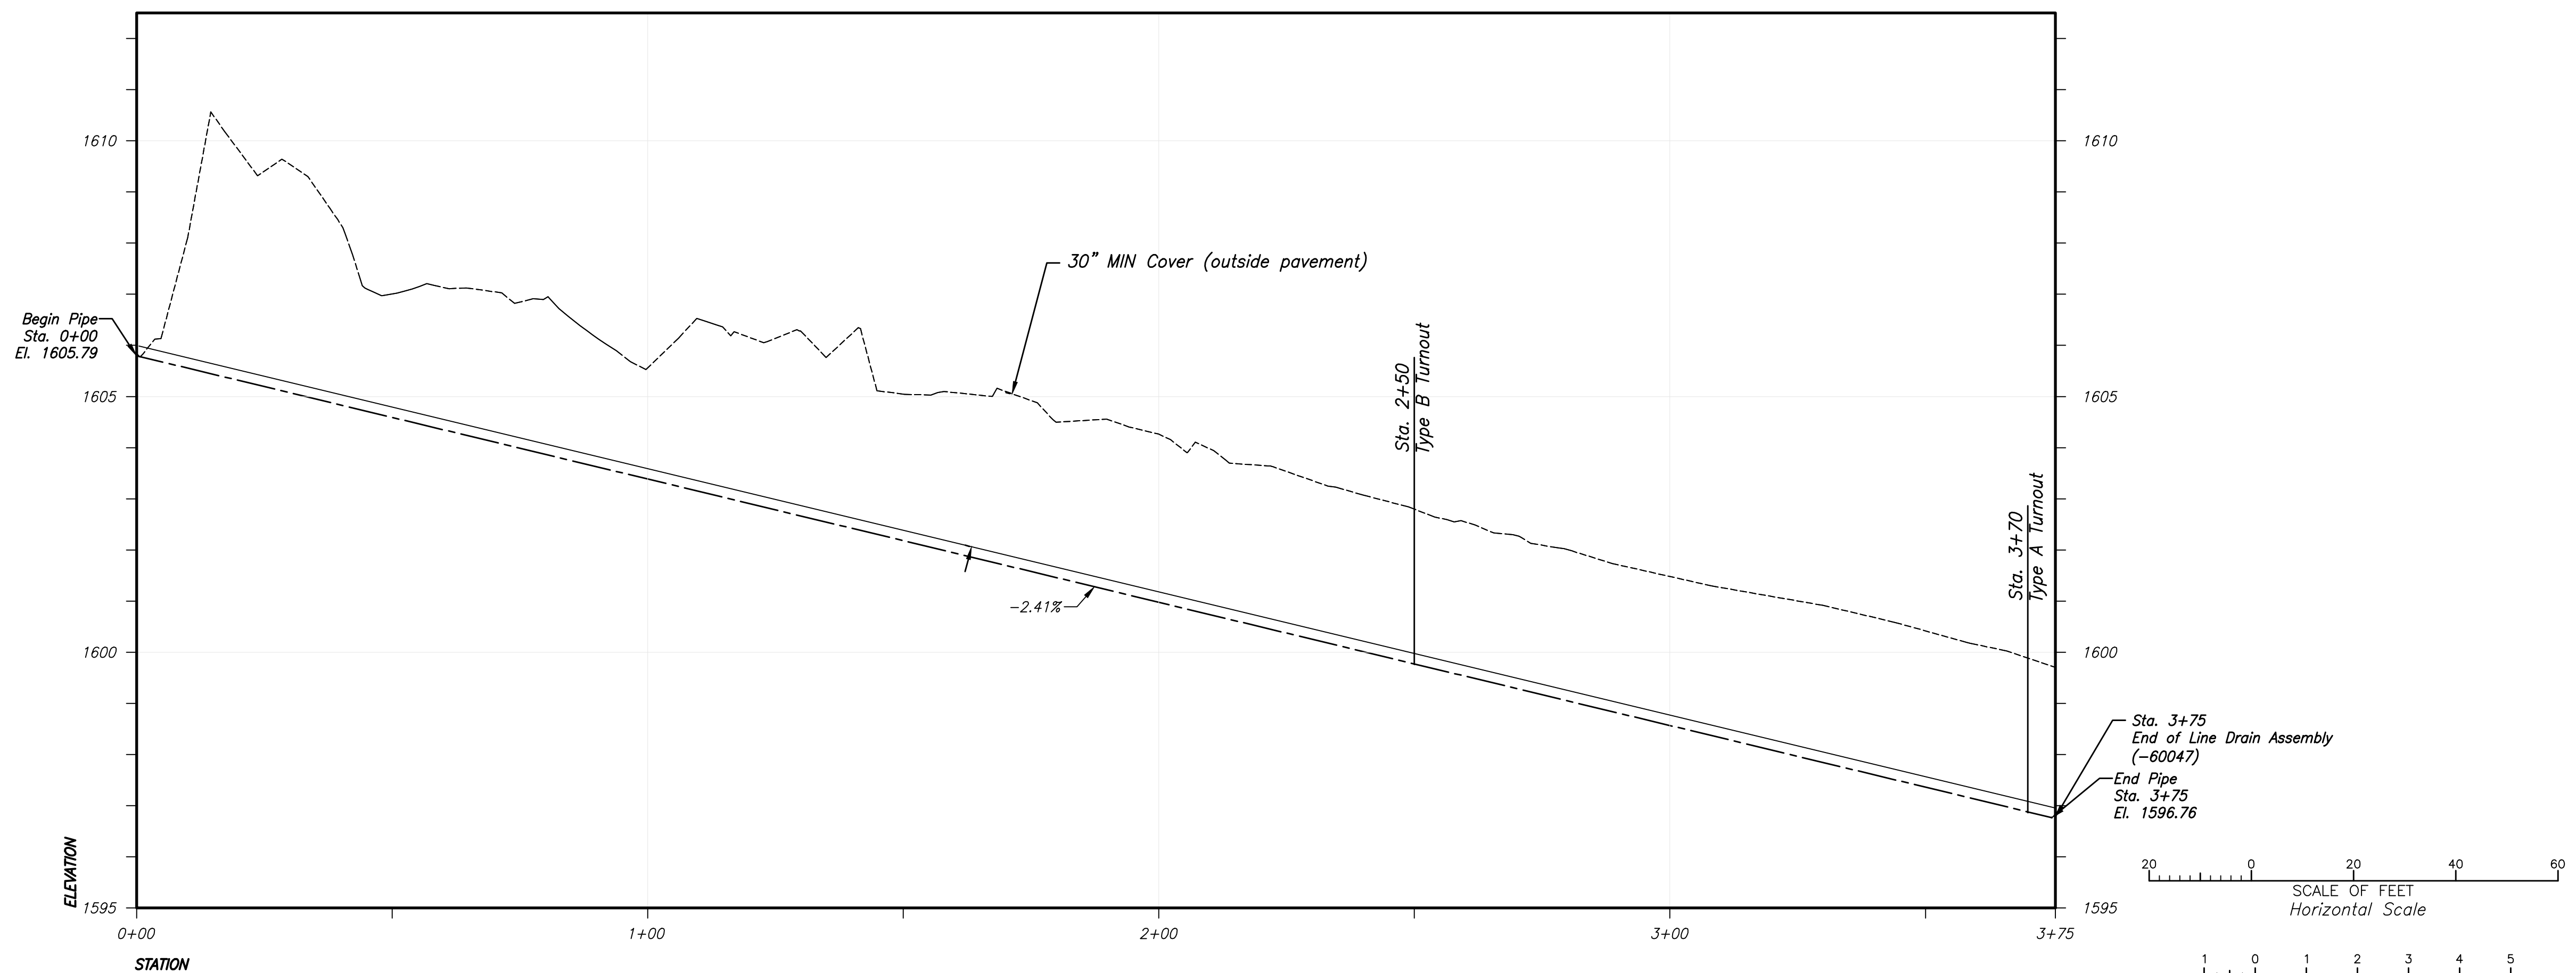


E3 LATERAL PLAN

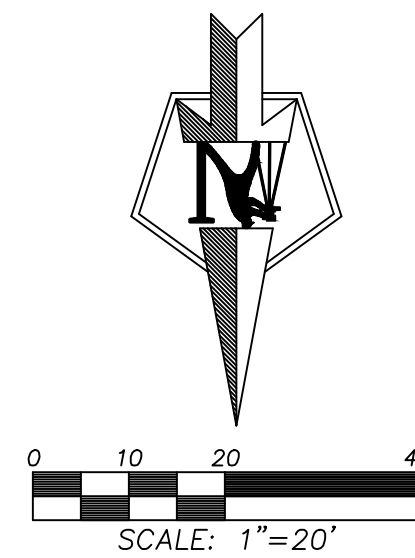


E3 LATERAL PROFILE

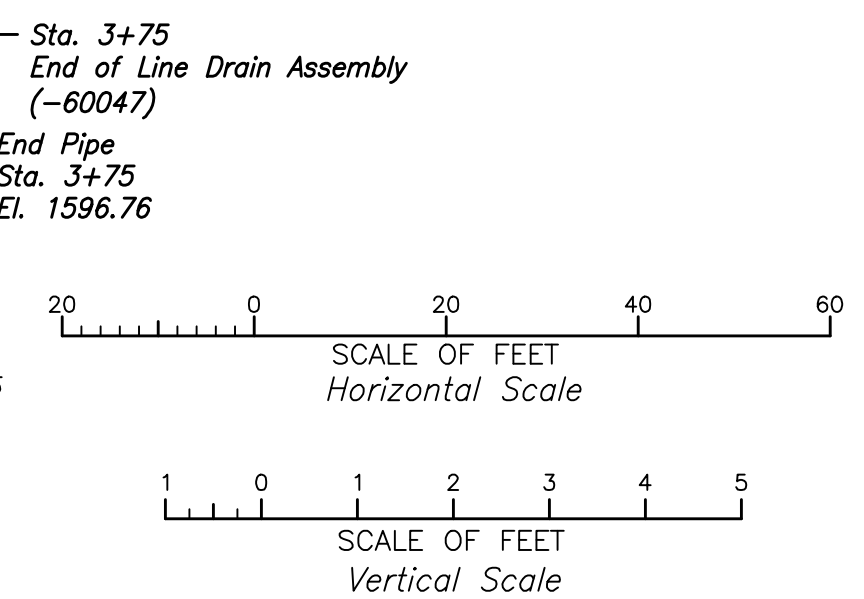


15044 PROJ. NO.	1 OF 6 SHT.	OKANOGAN COUNTY	METHOW SUBBASIN METHOW VALLEY IRRIGATION DISTRICT IRRIGATION AS-BUILTS	WASHINGTON	DATE: 2015-08-13	DWN:	FILE: 2015-08-12 METHOW MWD IRRIGATION AS-BUILTS	15 North Cleburn Ave. Wenatchee, WA 98801	Phone: 509-663-8680 Fax: 509-663-8278	REVISION	DATE

TURNING YOUR IDEAS INTO
REALITY THROUGH
INNOVATION INTEGRITY
AND PERSONAL SERVICE

Northwest
GEODIMENSIONS

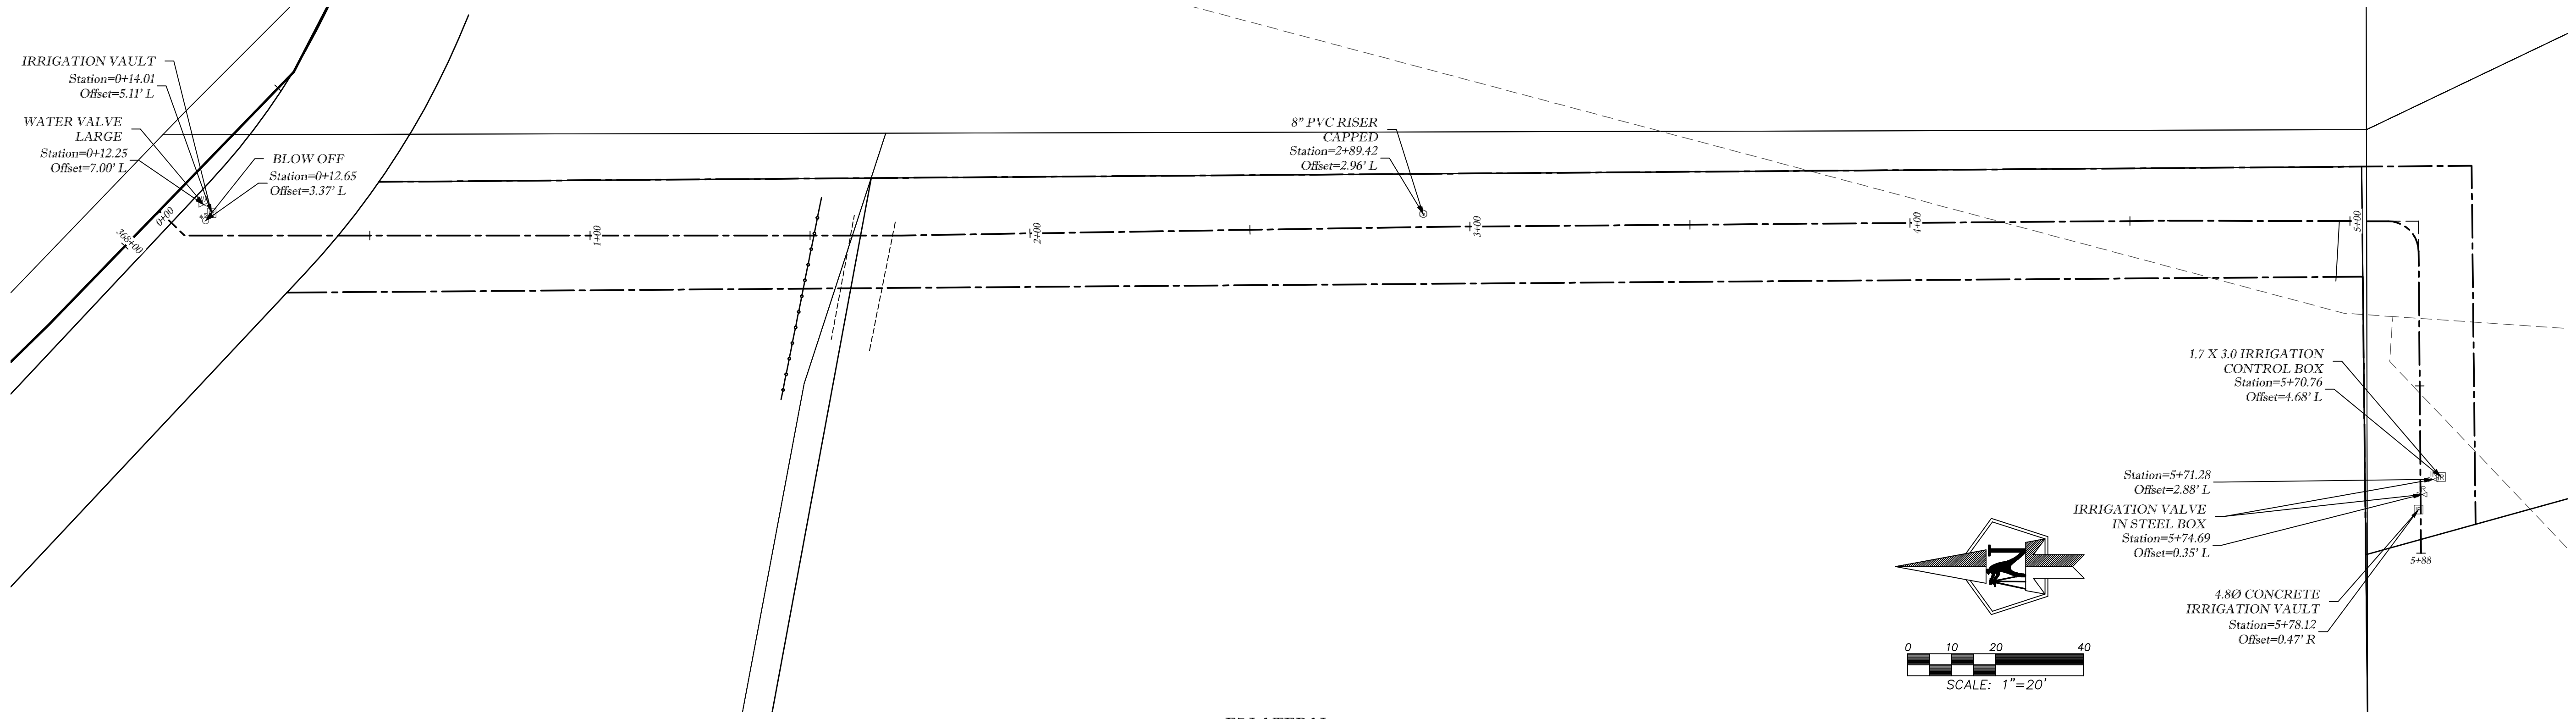


E7 LATERAL
PLAN

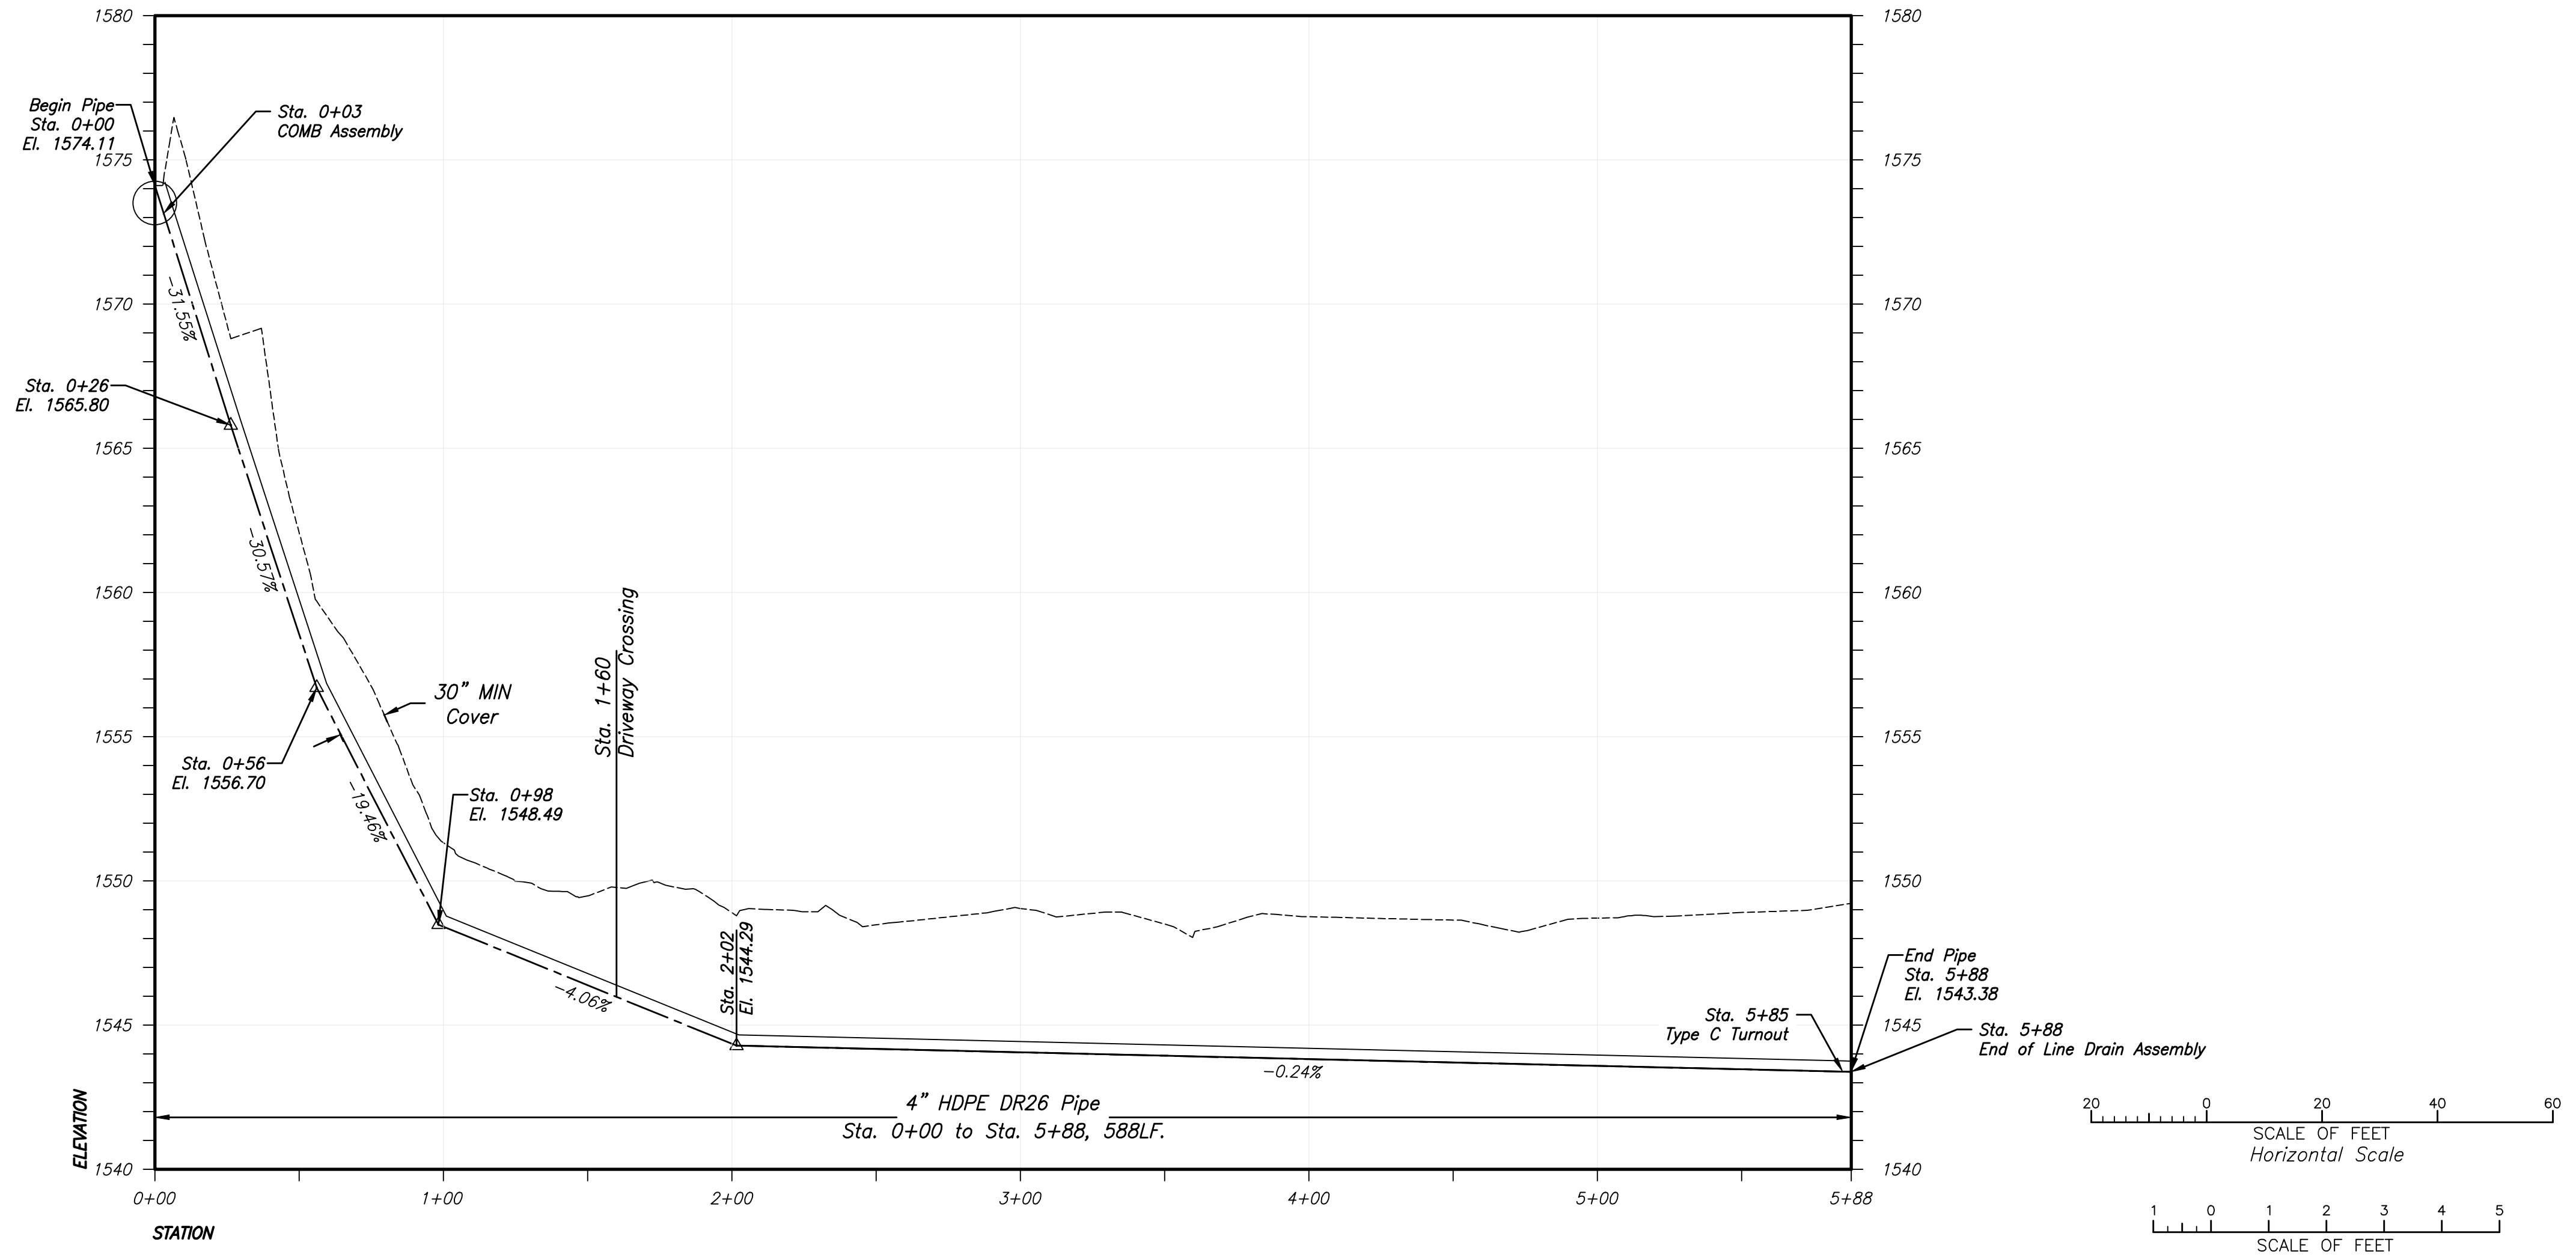



E7 LATERAL PROFILE





15044	PROJ. NO.
2 OF 6	SHT.
OKANOGAN COUNTY WASHINGTON METHOW SUBBASIN METHOW VALLEY IRRIGATION DISTRICT IRRIGATION AS-BUILTS	
TURNING YOUR IDEAS INTO REALITY THROUGH INNOVATION INTEGRITY AND PERSONAL SERVICE	
NORTHWEST GEODIMENSIONS	
15 North Chelan Ave. Wenatchee, WA 98801 Phone 309-663-8660 Fax 309-663-8276	
DESIGN	DATE
DRAWN	DATE
CHECKED	DATE
APPROVED	DATE

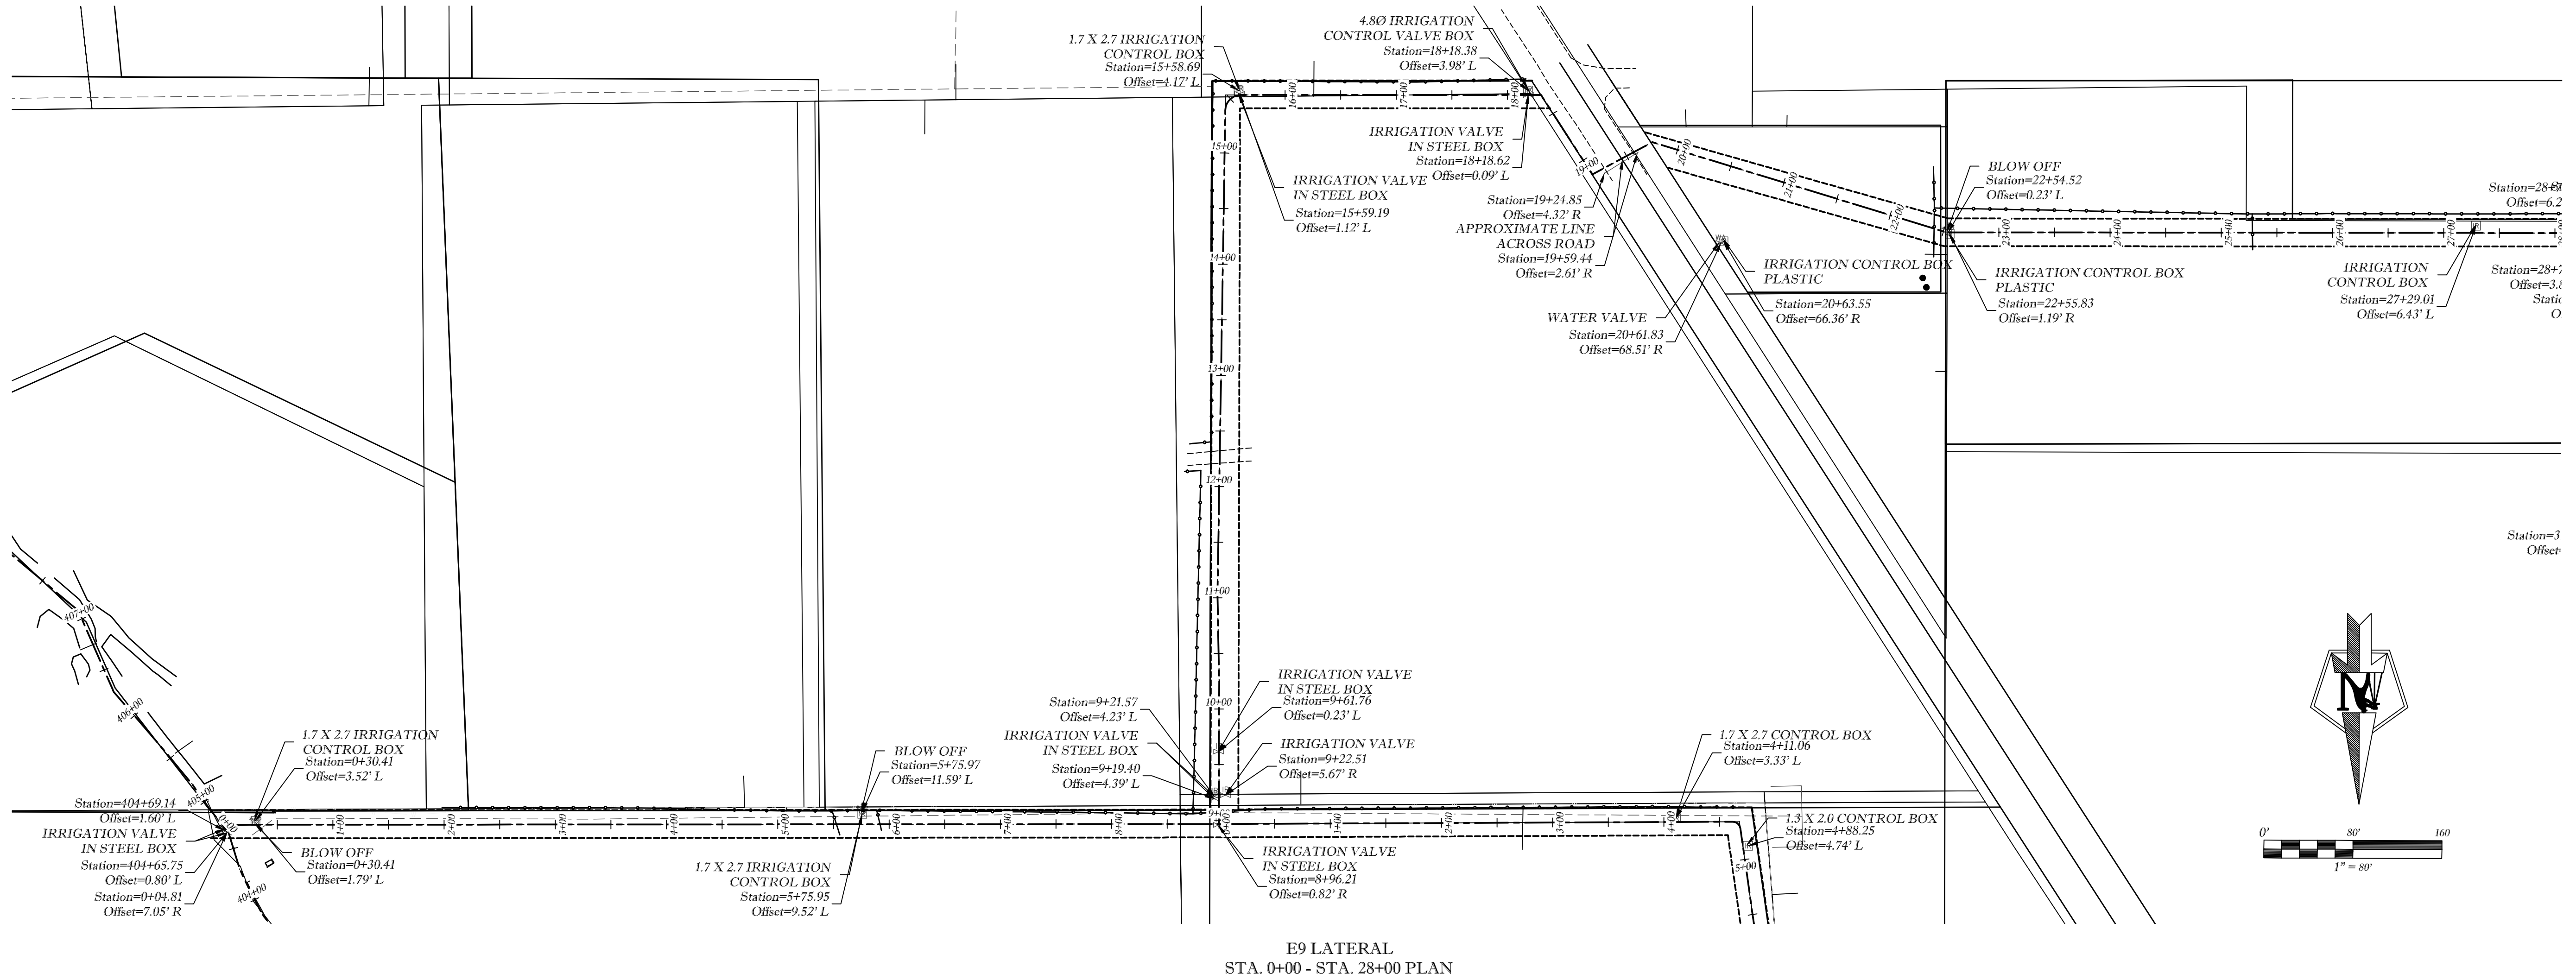


E9 LATERAL
STA. 0+00 - STA. 28+00 PLAN

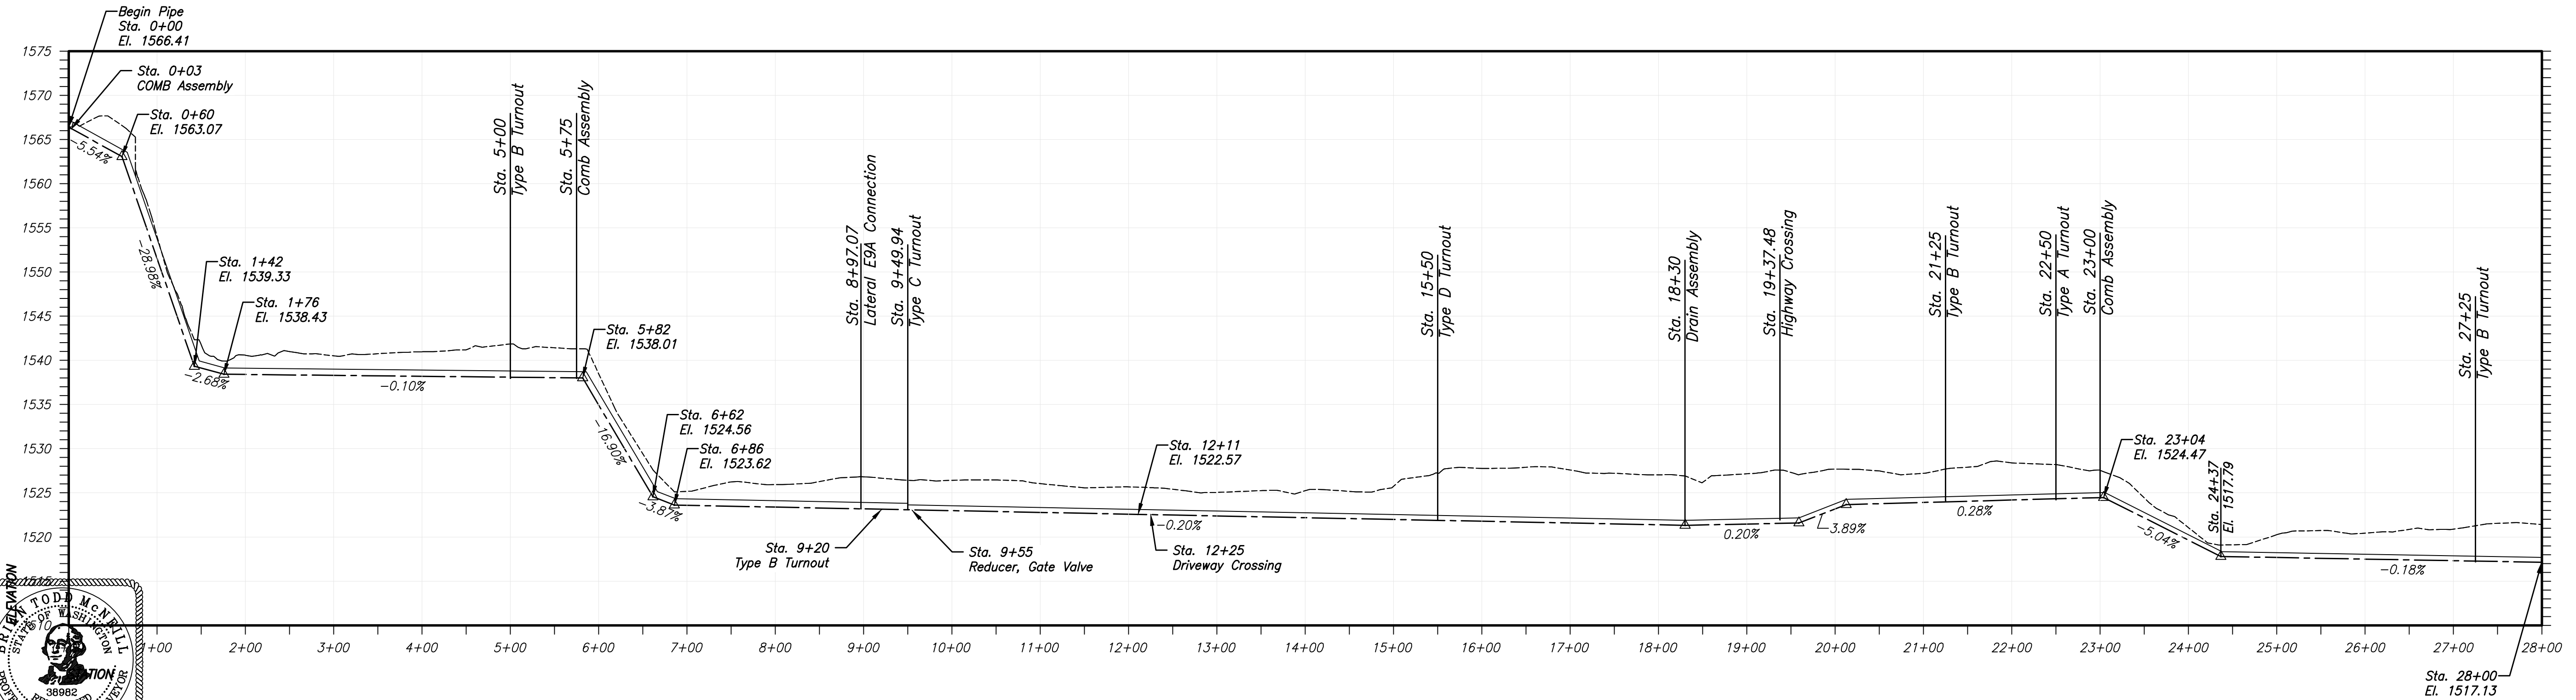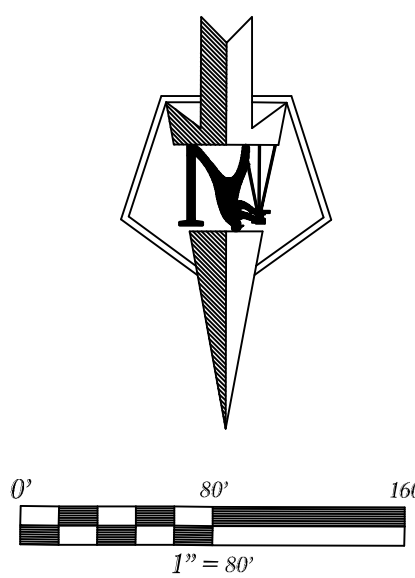


E9 LATERAL PROFILE

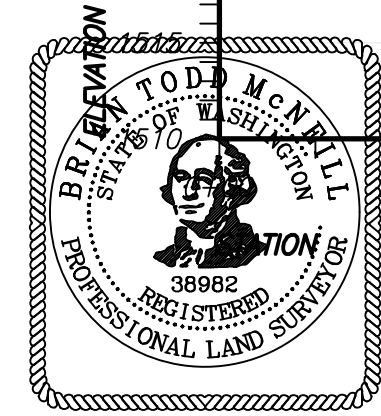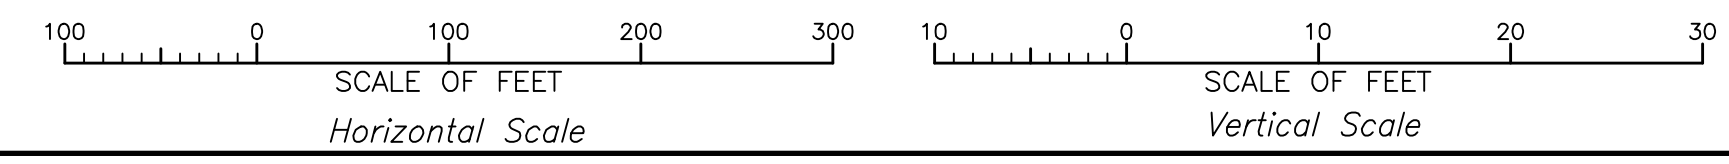



15044	PROJ. NO.	3 OF 6	SHEET
METHOW SUBBASIN METHOW VALLEY IRRIGATION DISTRICT IRRIGATION AS-BUILTS			
OKANOGAN COUNTY			
WASHINGTON		DATE: 08-13	DWG.
FILE: 2015-08-12 METHOW WVD IRRIGATION AS-BUILTS			
TURNING YOUR IDEAS INTO REALITY THROUGH INNOVATION, INTEGRITY AND PERSONAL SERVICE		REVISION	DATE
Northwest GEODIMENSIONS		15 North Cullen Ave., Wenatchee, WA 98801	Phone: 509-663-8660
FAX: 509-663-8660		E-MAIL: GESC@NWGEO.COM	

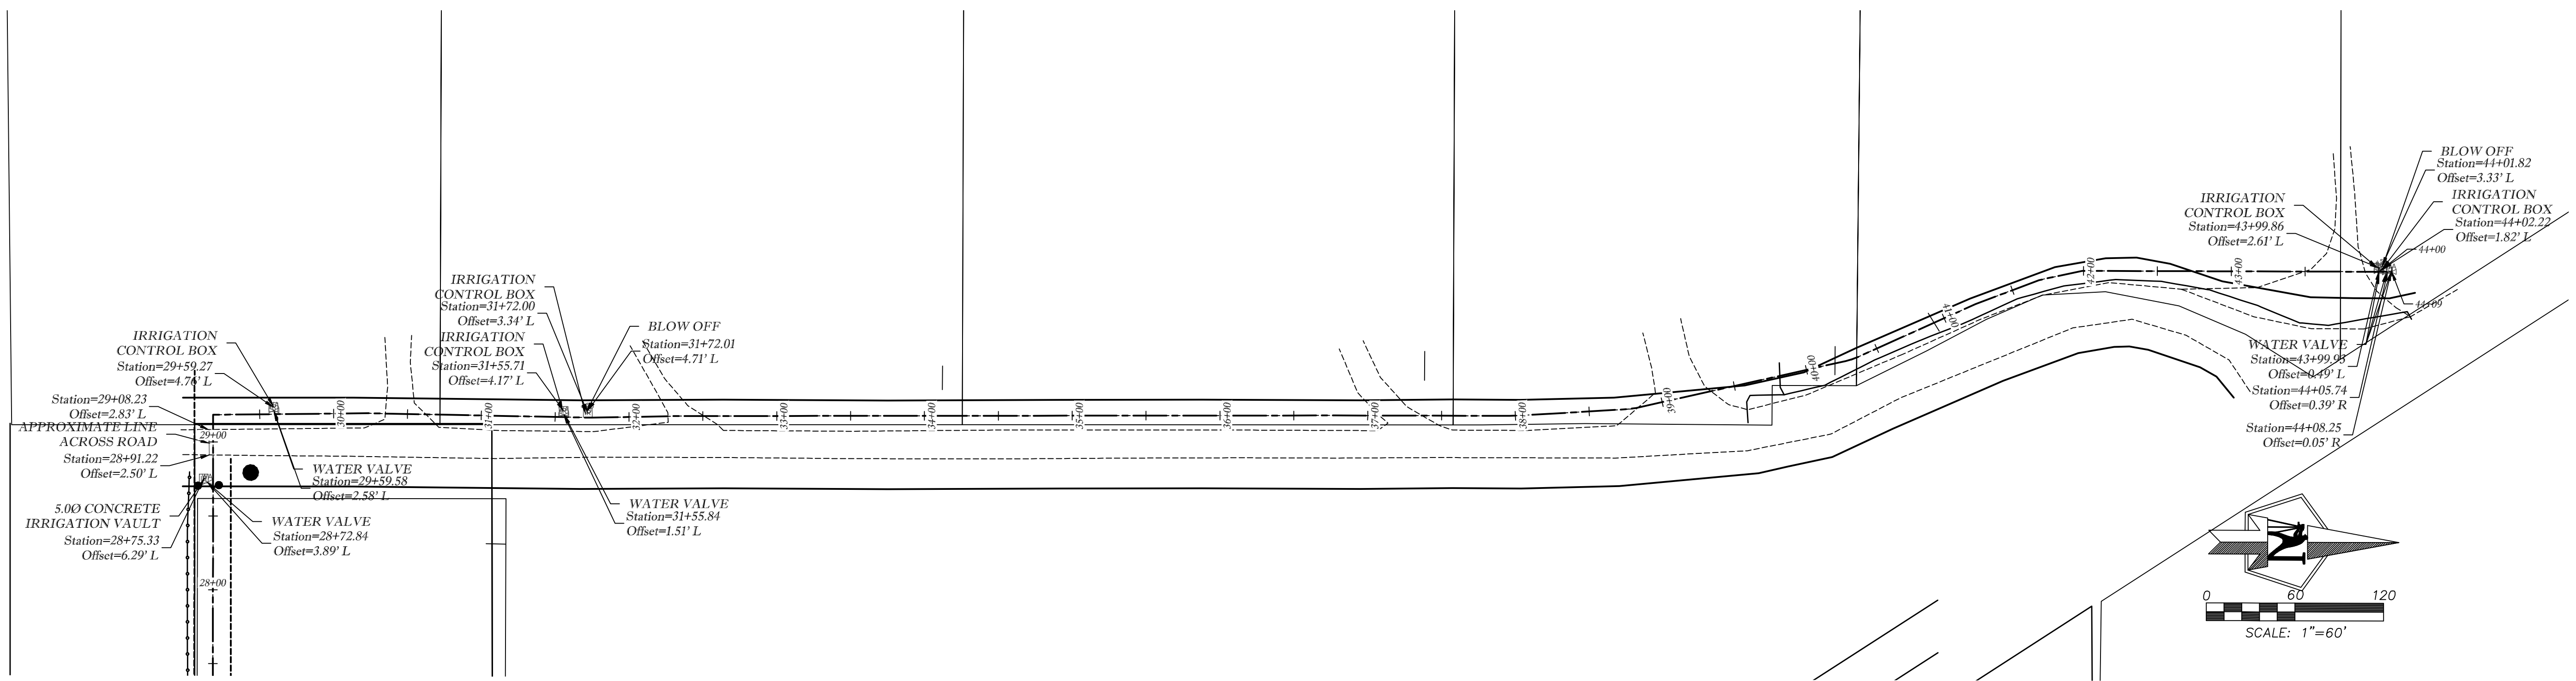


E9 LATERAL
STA. 28+00 - STA. 44+09 PLAN

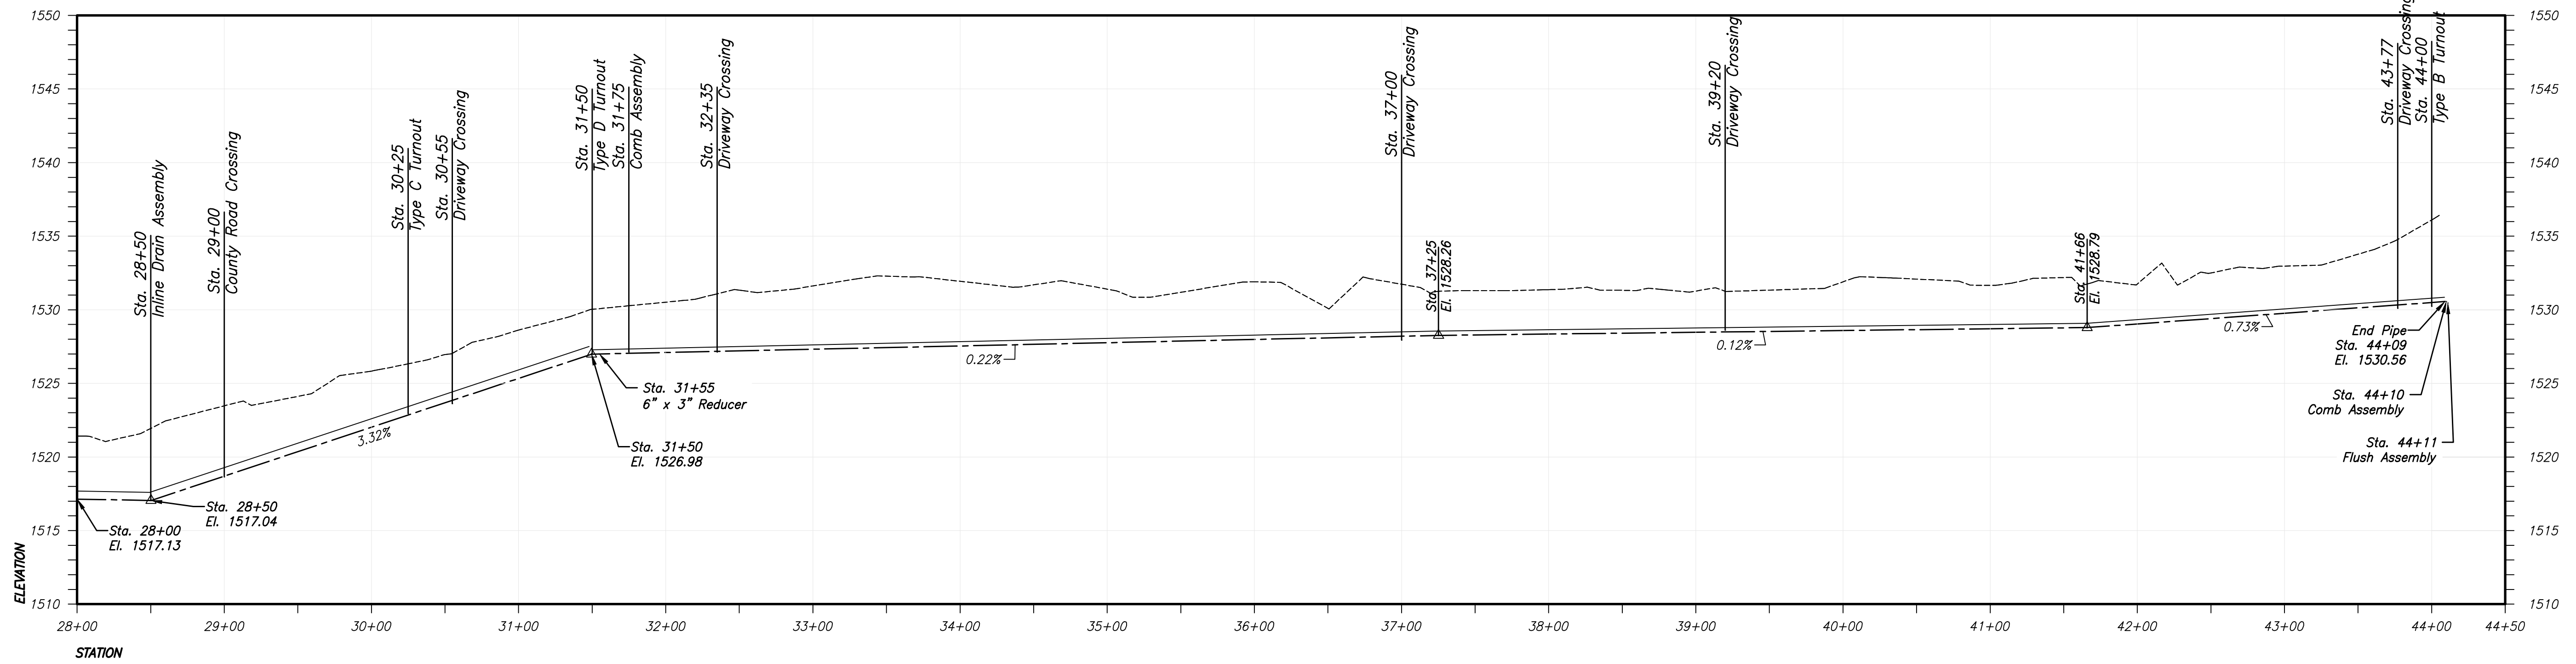


E9 LATERAL PROFILE

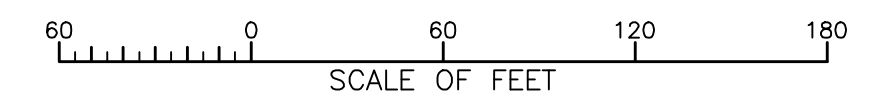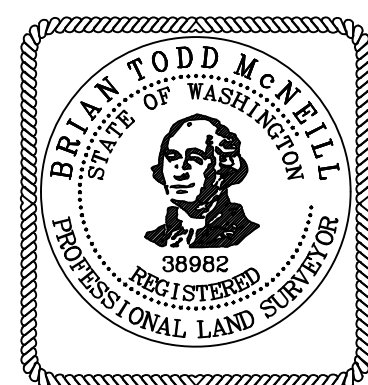


15044	PROJ. NO.
4 OF 6	SHT.
OKANOGAN COUNTY WASHINGTON METHOW SUBBASIN METHOW VALLEY IRRIGATION DISTRICT IRRIGATION AS-BUILTS DATE: 2015-08-13 DWG. FILE: 2015-08-12 METHOW WVD IRRIGATION AS-BUILTS 15 North Chelan Ave. Wenatchee, WA 98801 Phone: 509-663-8680 Fax: 509-663-8278 TURNING YOUR IDEAS INTO REALITY THROUGH INNOVATION, INTEGRITY AND PERSONAL SERVICE NORTHWEST GEODIMENSIONS DESCRIPTION	
DATE	BY

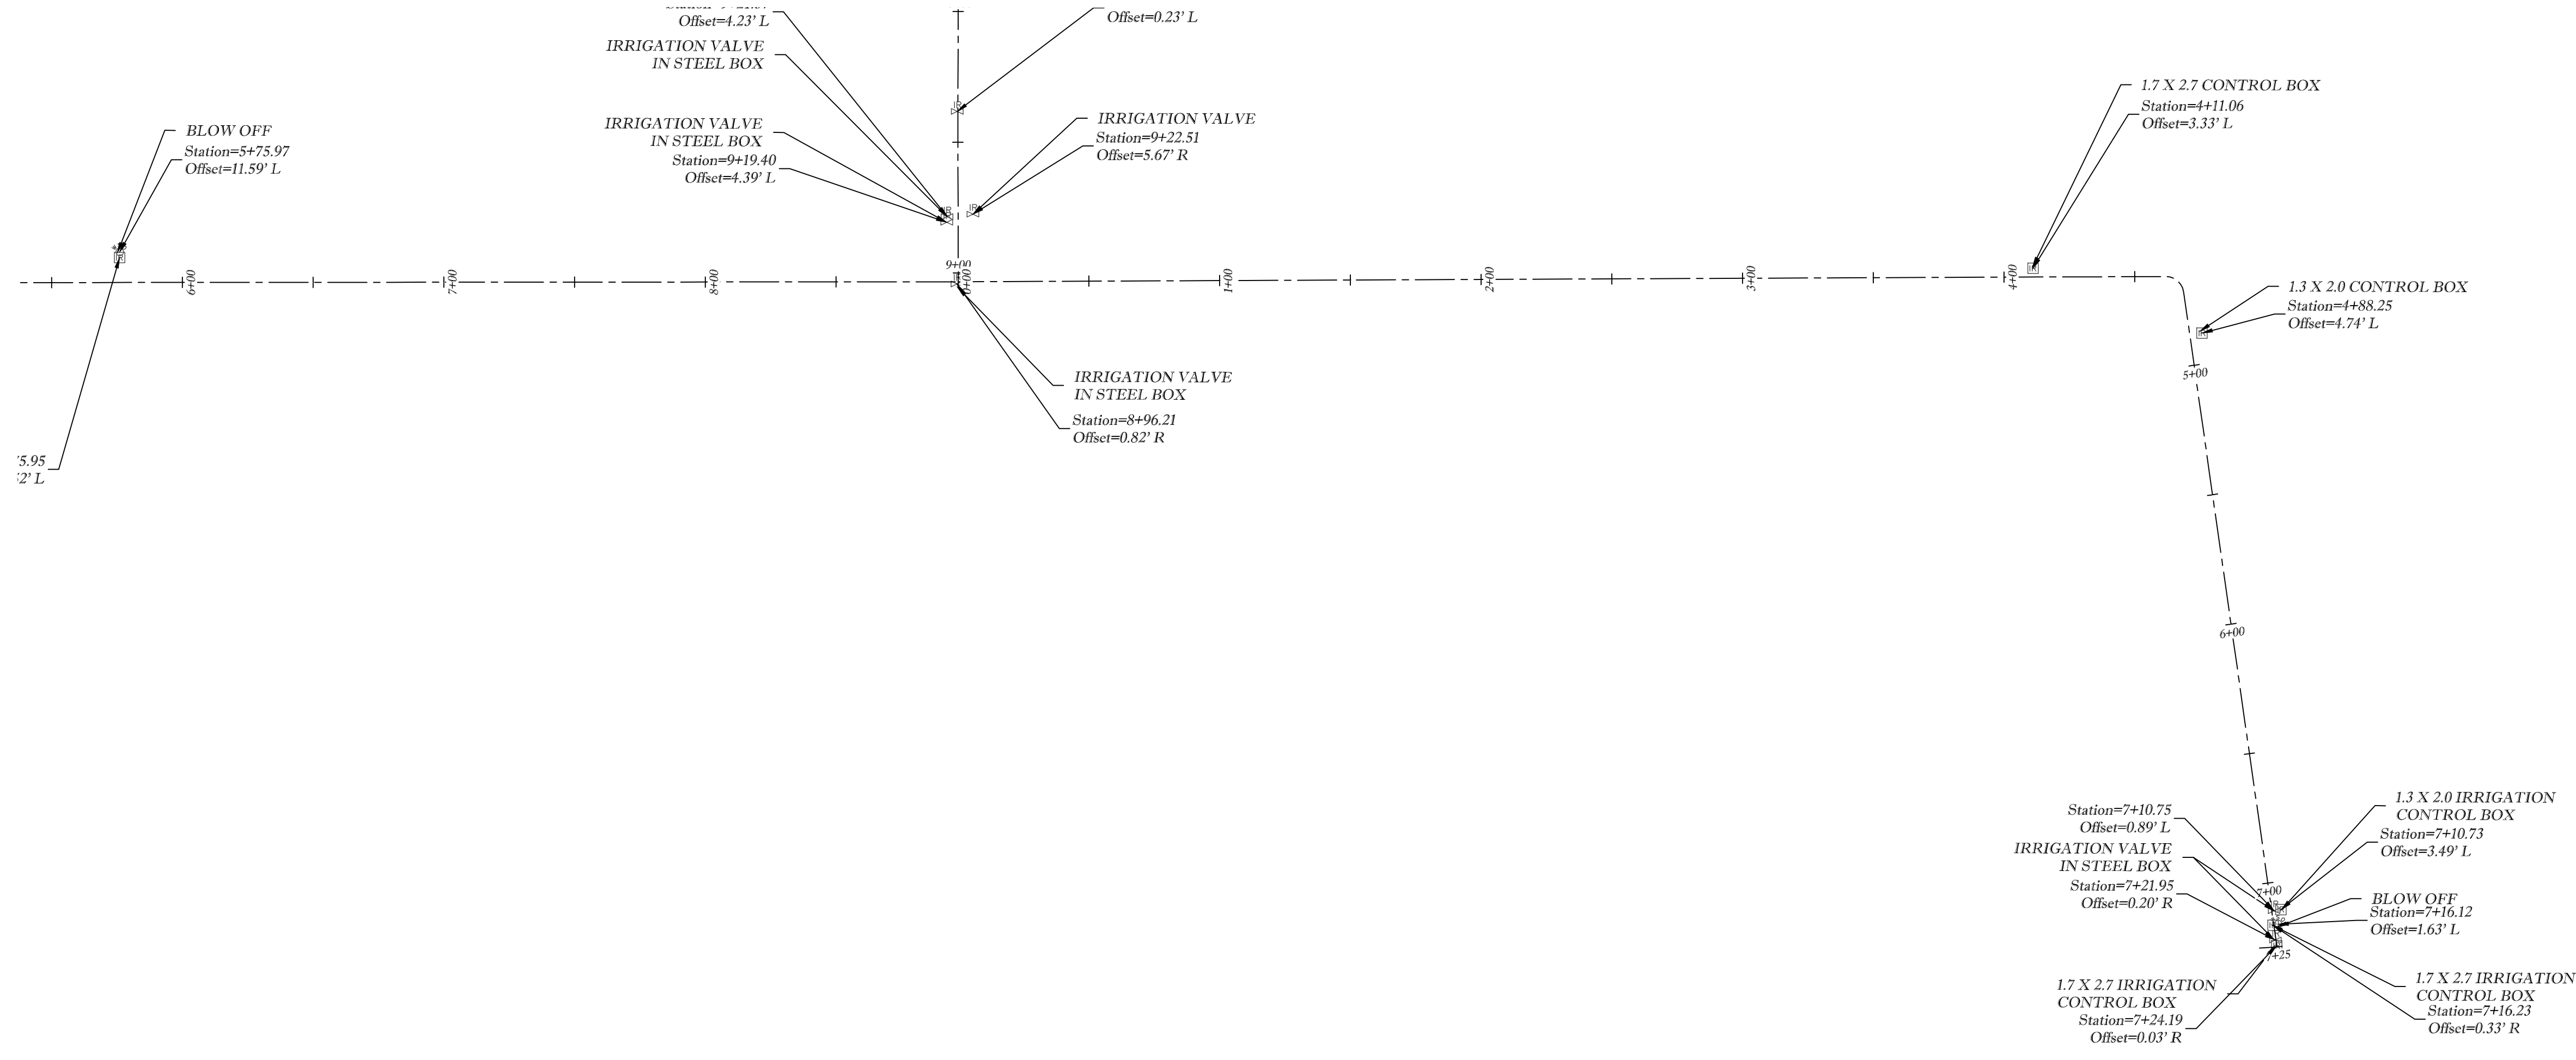

E9 A LATERAL PLAN

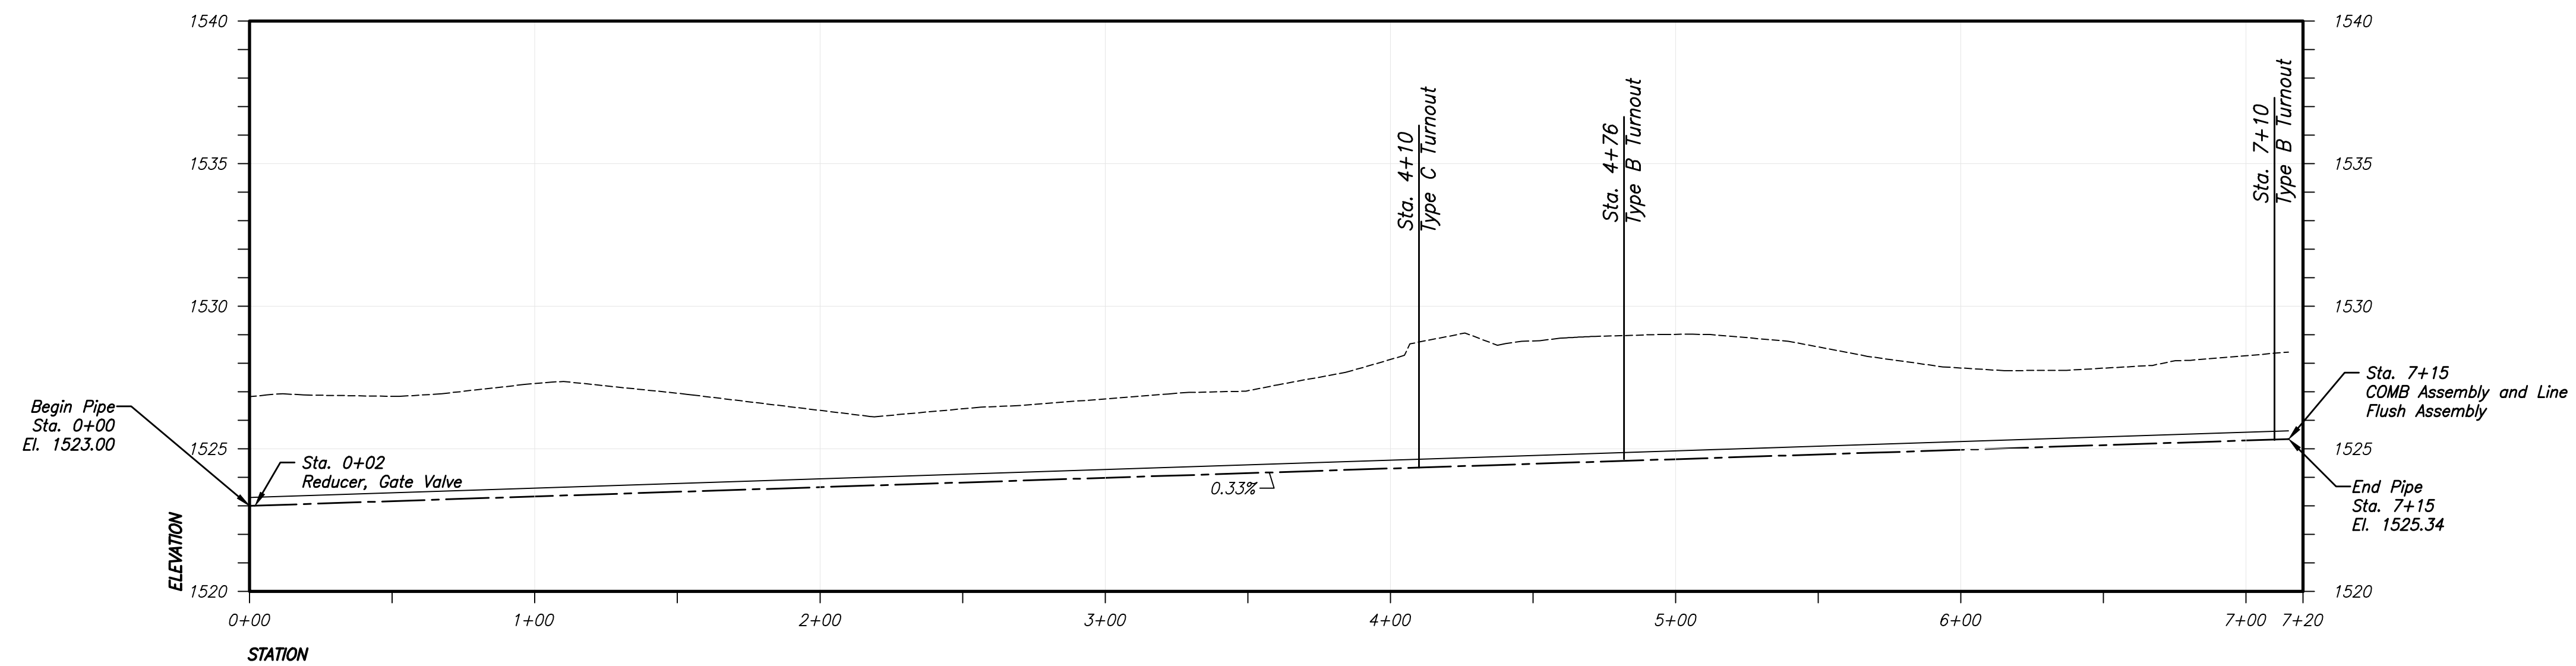

E9 A LATERAL PROFILE

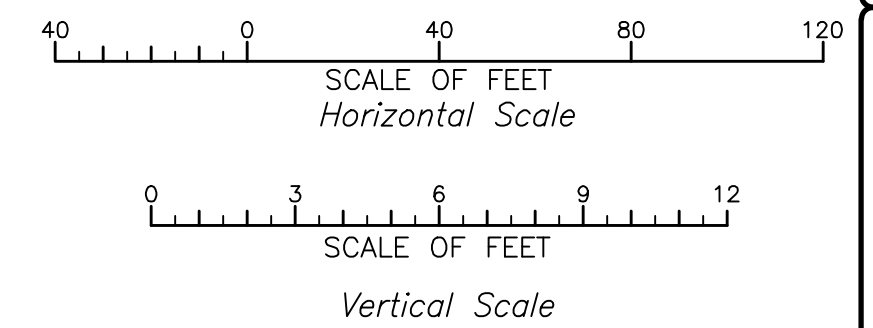

TURNING YOUR IDEAS INTO REALITY THROUGH INNOVATION, INTEGRITY AND PERSONAL SERVICE





Northwest GEODIMENSIONS

13 North Chelton Ave. - Wenatchee, WA 98801
 Phone: 509-663-8680 Fax: 509-663-8278

METHOW SUBBASIN
 METHOW VALLEY IRRIGATION DISTRICT
 IRRIGATION AS-BUILTS

OKANOGAN COUNTY WASHINGTON

DATE: 2015-08-13
 DRAWN: []
 FILE: 2015-08-12 METHOW MWD IRRIGATION AS-BUILTS

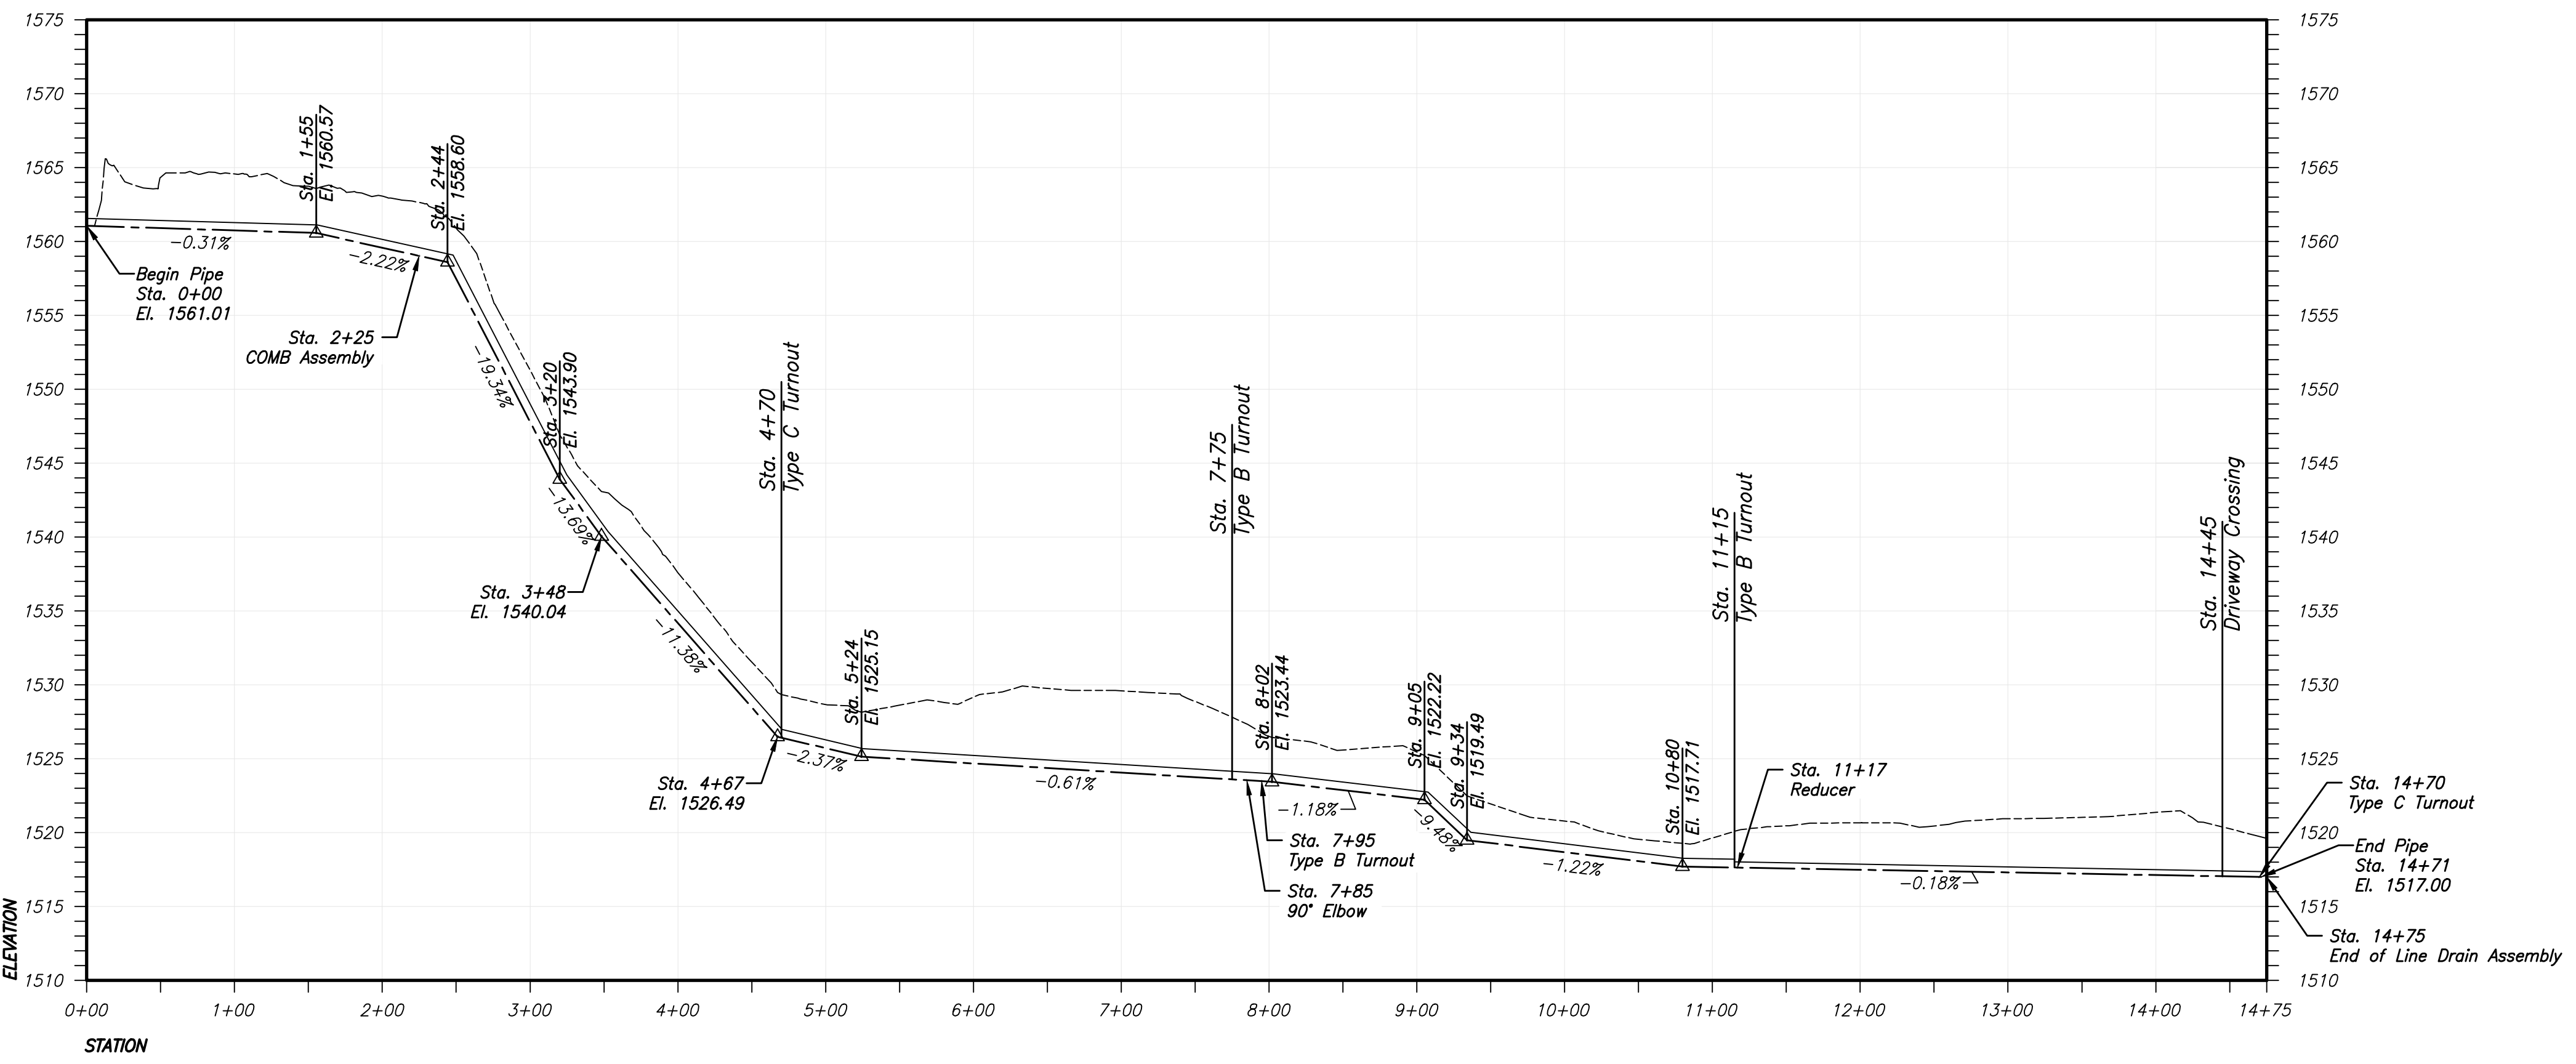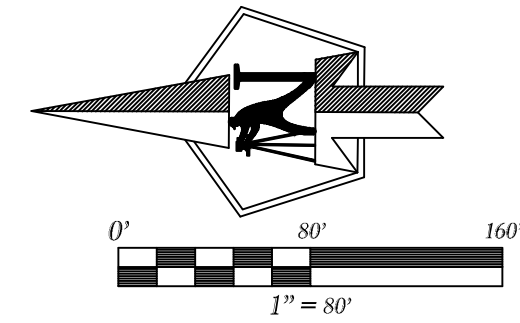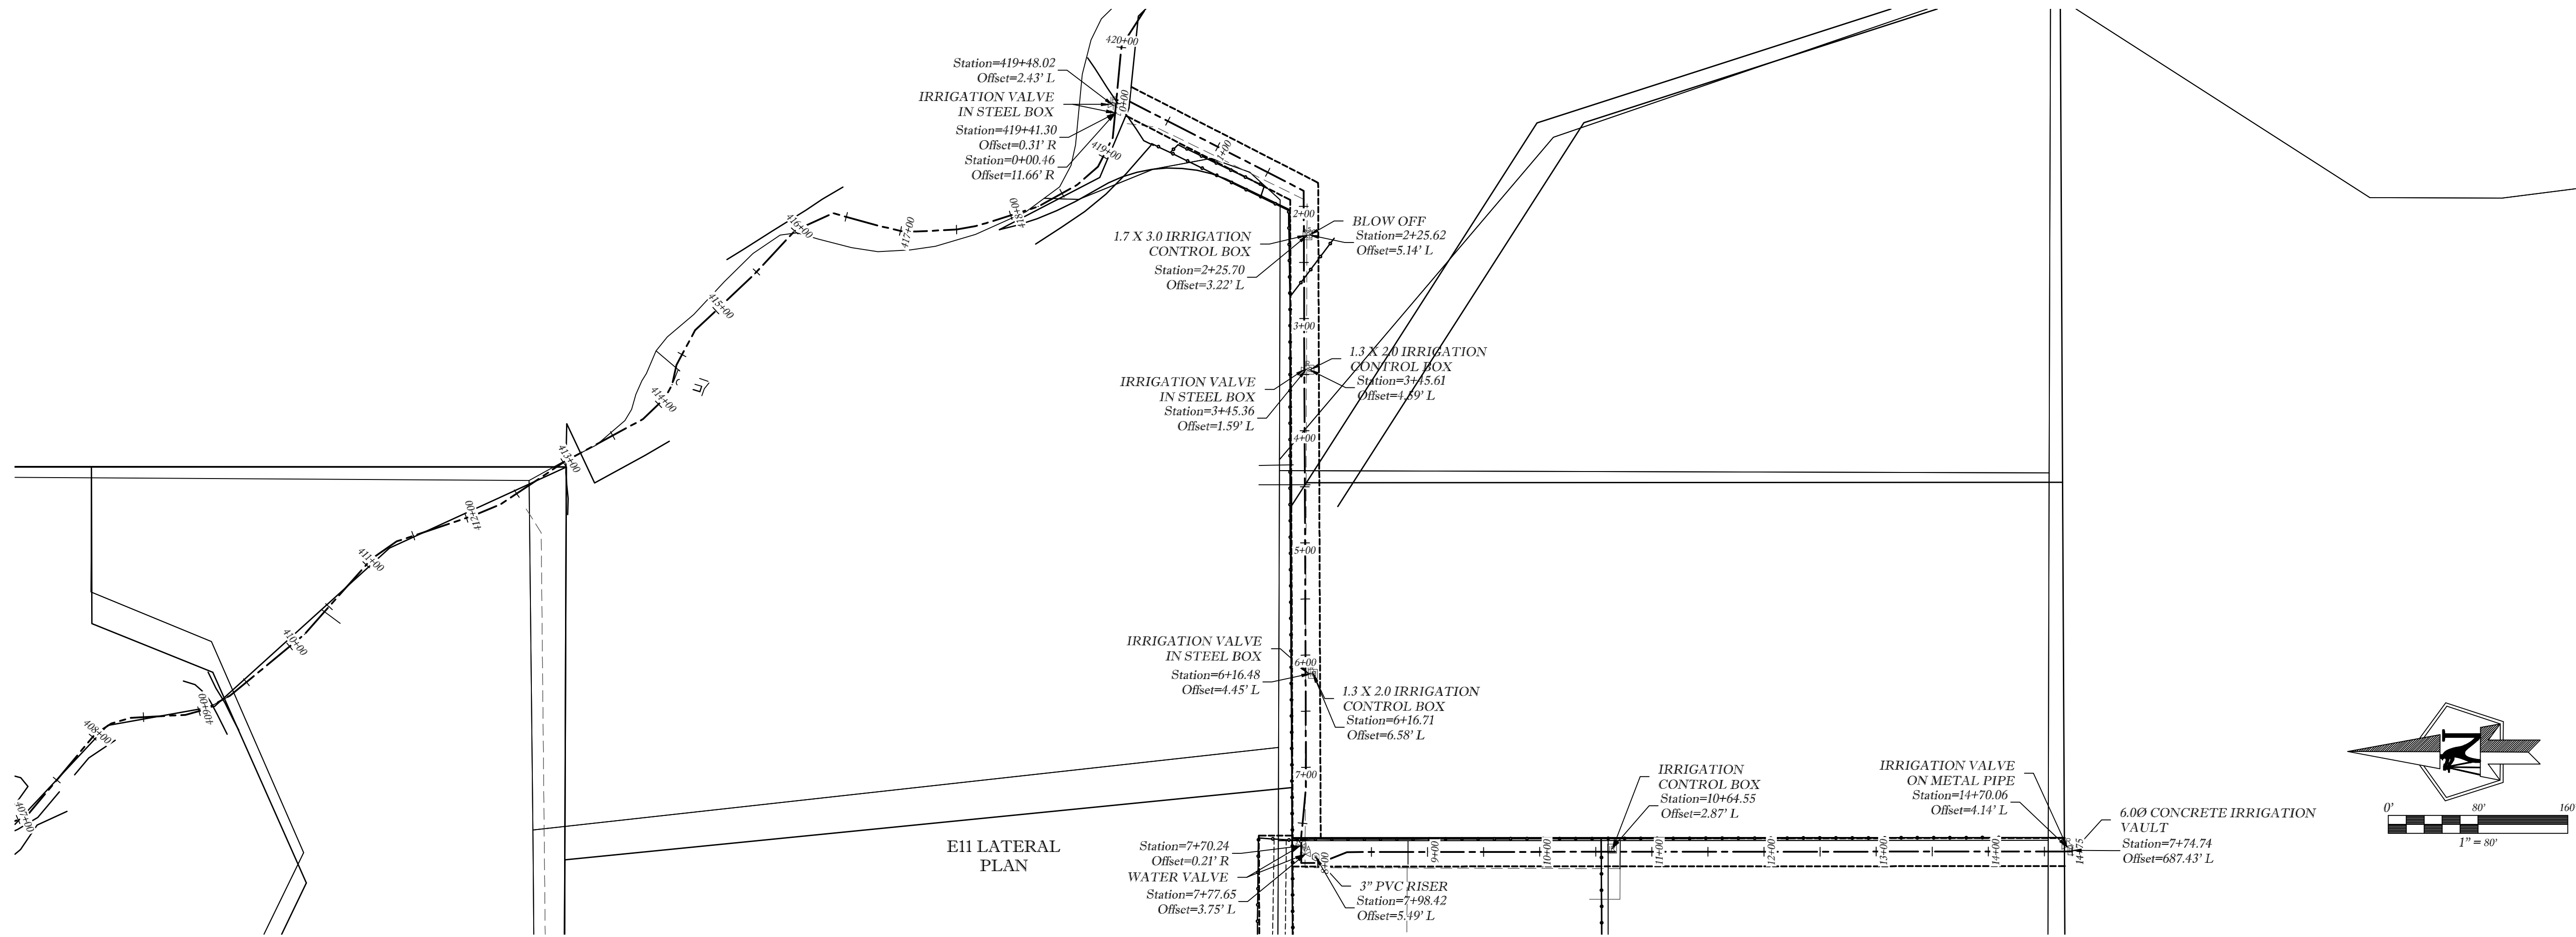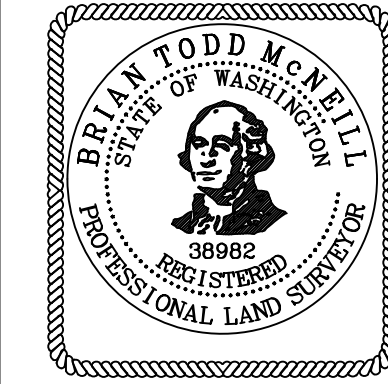

E11 LATERAL PROFILE

SCALE OF FEET 160 240

15044		6 OF 6		DATE		BY	
PROJ. NO.		SHEET		REVISION		DATE	
METHOW SUBBASIN METHOW VALLEY IRRIGATION DISTRICT IRRIGATION AS-BUILTS OKANOGAN COUNTY WASHINGTON							
TURNING YOUR IDEAS INTO REALITY THROUGH INNOVATION INTEGRITY AND PERSONAL SERVICE Northwest GEODIMENSIONS 13 North Cleaton Ave. - Wenatchee, WA 98801 Phone 509-663-8680 Fax 509-663-8278 E: info@northwestgeodimensions.com W: www.northwestgeodimensions.com							