



**ASBUILTS**  
M.V.I.D. E1 IRRIGATION PROJECT  
TOWN OF TWISP, WASHINGTON

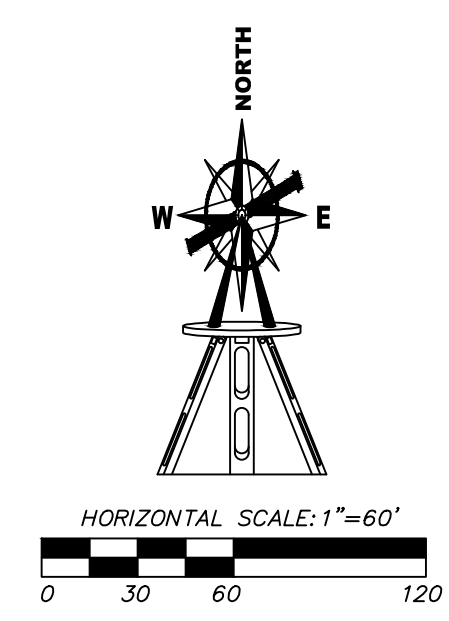


- LEGEND**
- WV IRRIGATION WATER VALVE
  - IRRIGATION SERVICE
  - AIR VAC ASSEMBLY
  - IRRIGATION DRAIN ACCESS PANEL
  - IRRIGATION LINE
  - - - EASEMENT LINE

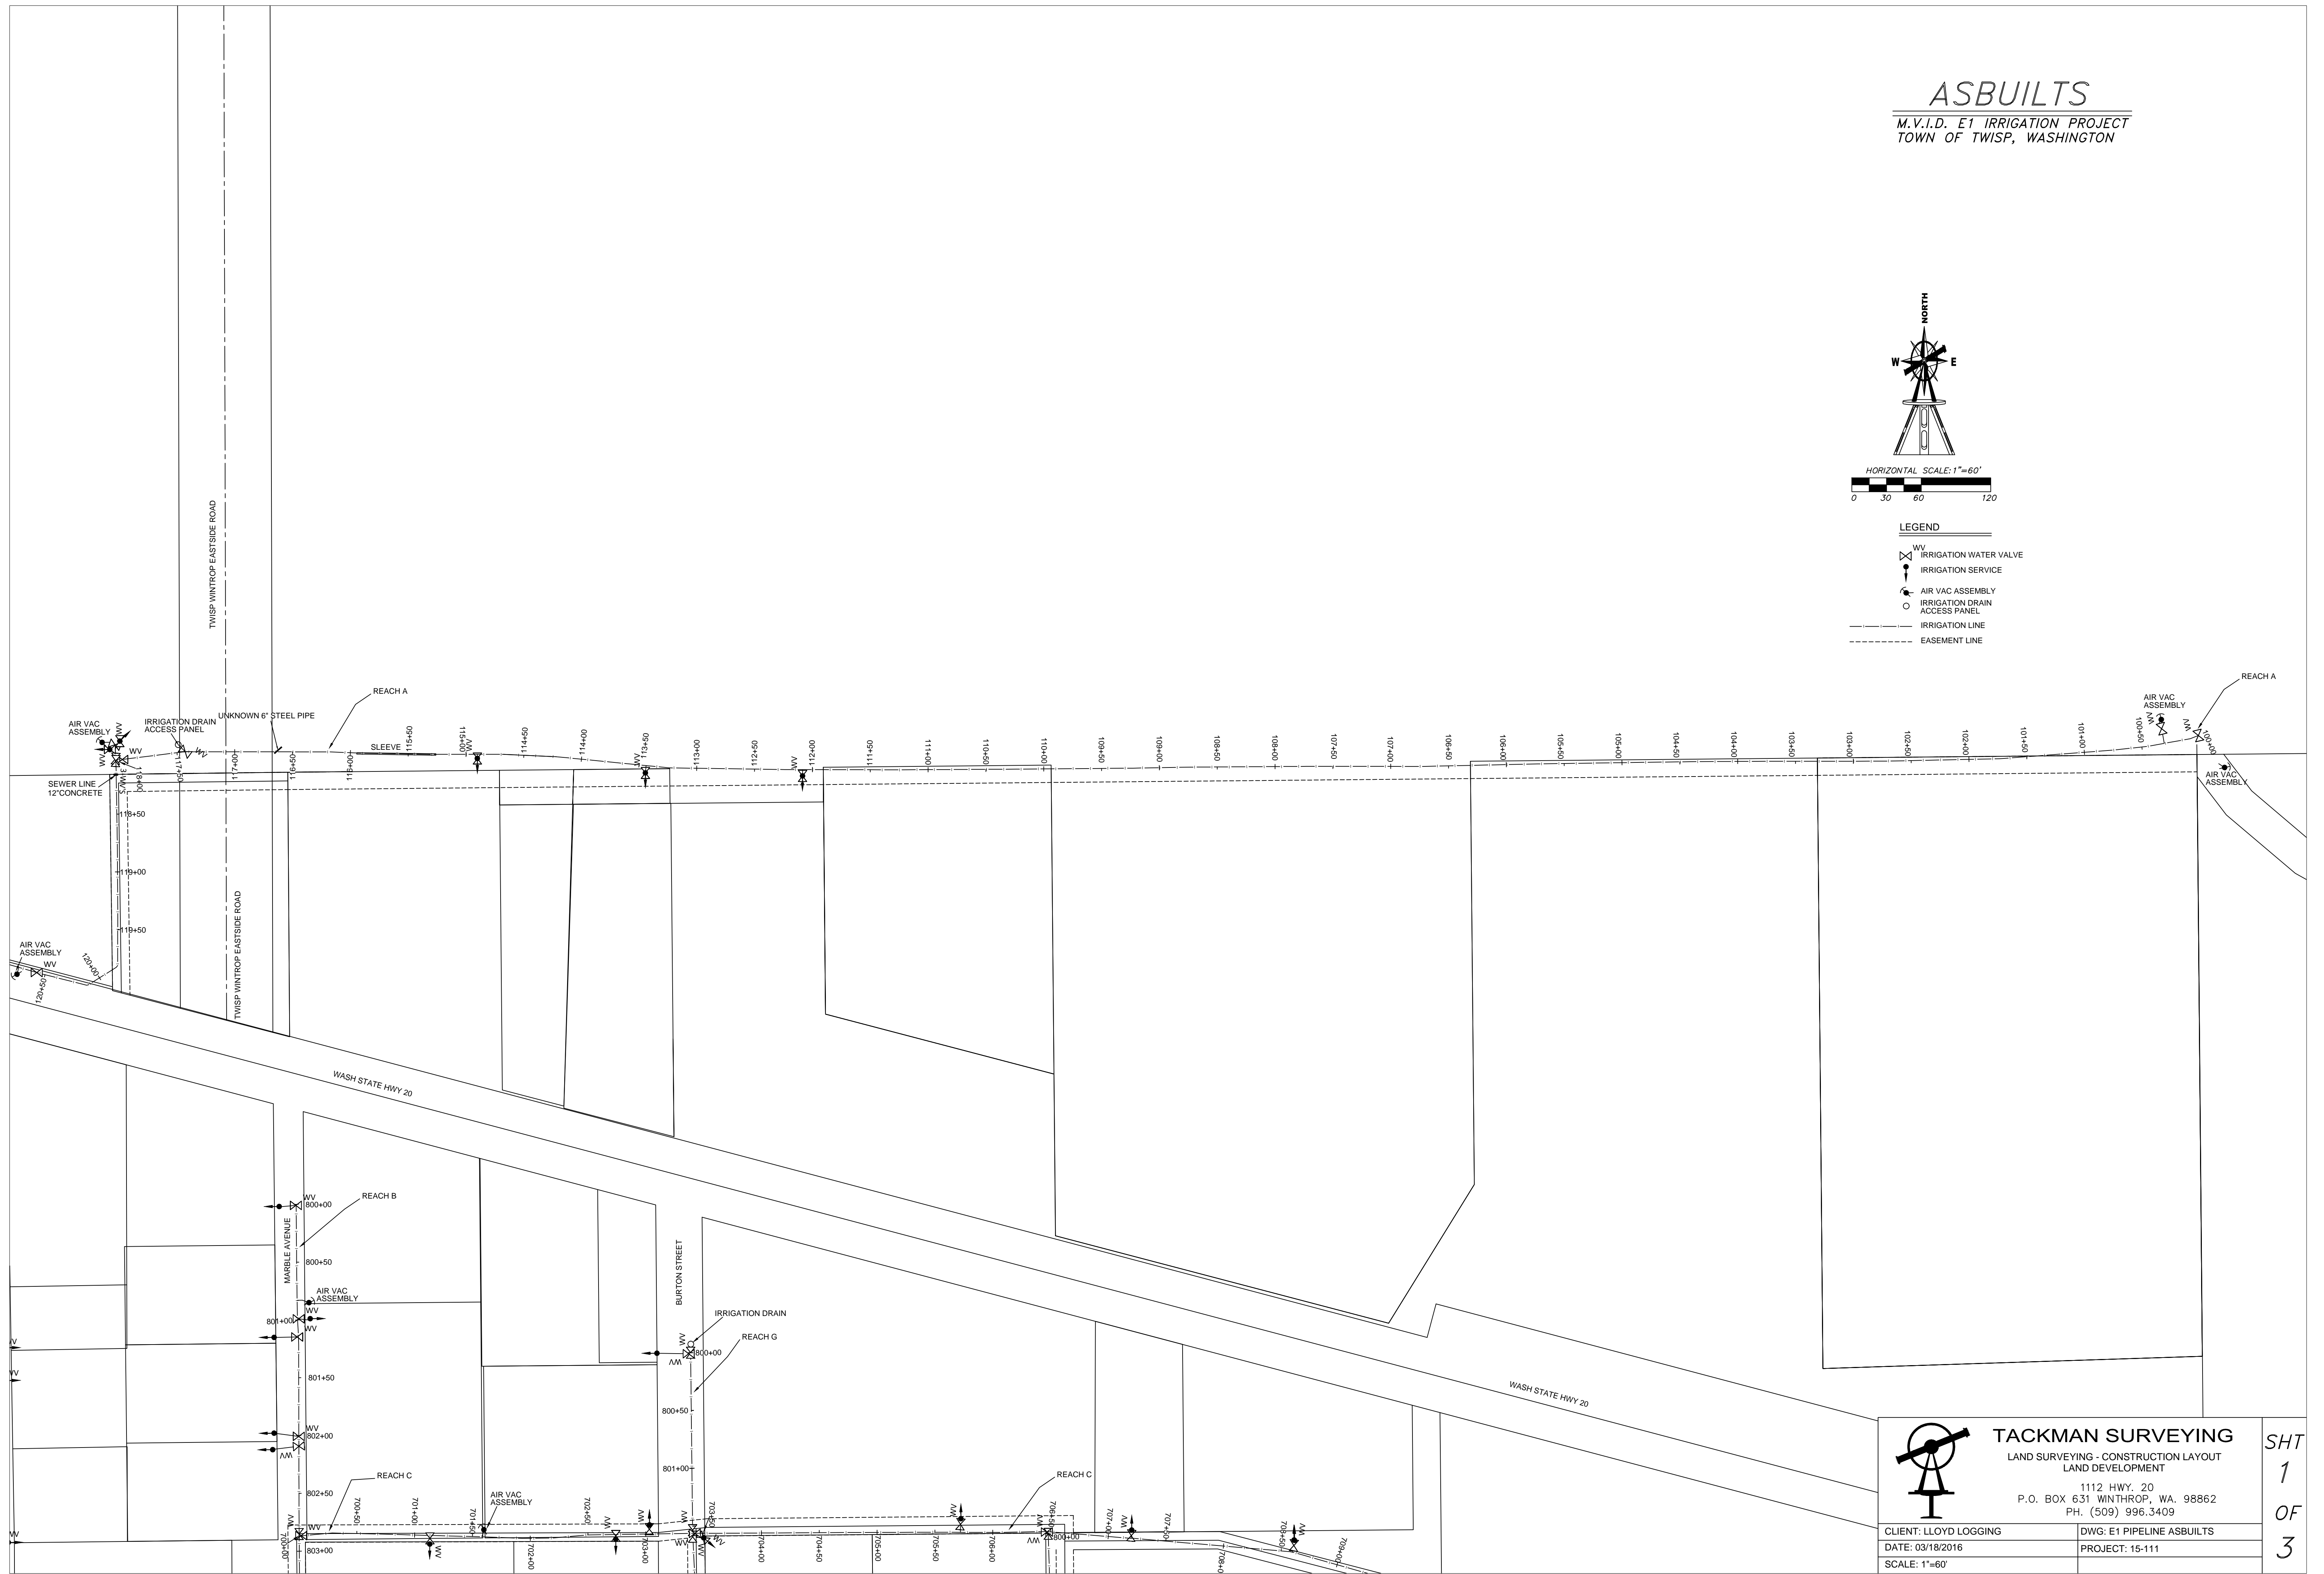

	<b>TACKMAN SURVEYING</b>	
	LAND SURVEYING - CONSTRUCTION LAYOUT LAND DEVELOPMENT 1112 HWY. 20 P.O. BOX 631 WINTHROP, WA. 98862 PH. (509) 996.3409	
CLIENT: LLOYD LOGGING	DWG: E1 PIPELINE ASBUILTS	
DATE: 03/18/2016	PROJECT: 15-111	
SCALE: 1"=60'		

SHT  
1  
OF  
3


**ASBUILTS**  
M.V.I.D. E1 IRRIGATION PROJECT  
TOWN OF TWISP, WASHINGTON

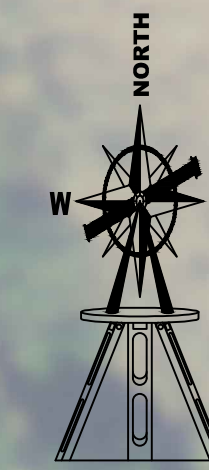

HORIZONTAL SCALE: 1"=60'  
0 30 60 120

**LEGEND**

- WV IRRIGATION WATER VALVE
- IR IRRIGATION SERVICE
- AA AIR VAC ASSEMBLY
- AD AIR VAC ASSEMBLY
- IR IRRIGATION LINE
- EL EASEMENT LINE

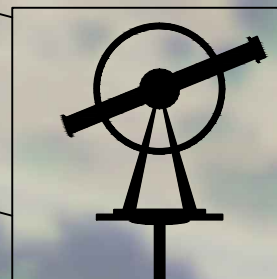


**TACKMAN SURVEYING**  
LAND SURVEYING - CONSTRUCTION LAYOUT  
LAND DEVELOPMENT  
1112 HWY. 20  
P.O. BOX 631 WINTHROP, WA. 98862  
PH. (509) 996.3409

CLIENT: LLOYD LOGGING  
DATE: 03/18/2016  
SCALE: 1"=60'


DWG: E1 PIPELINE ASBUILTS  
PROJECT: 15-111


SHT  
1  
OF  
3

**ASBUILTS**  
M.V.I.D. E1 IRRIGATION PROJECT  
TOWN OF TWISP, WASHINGTON

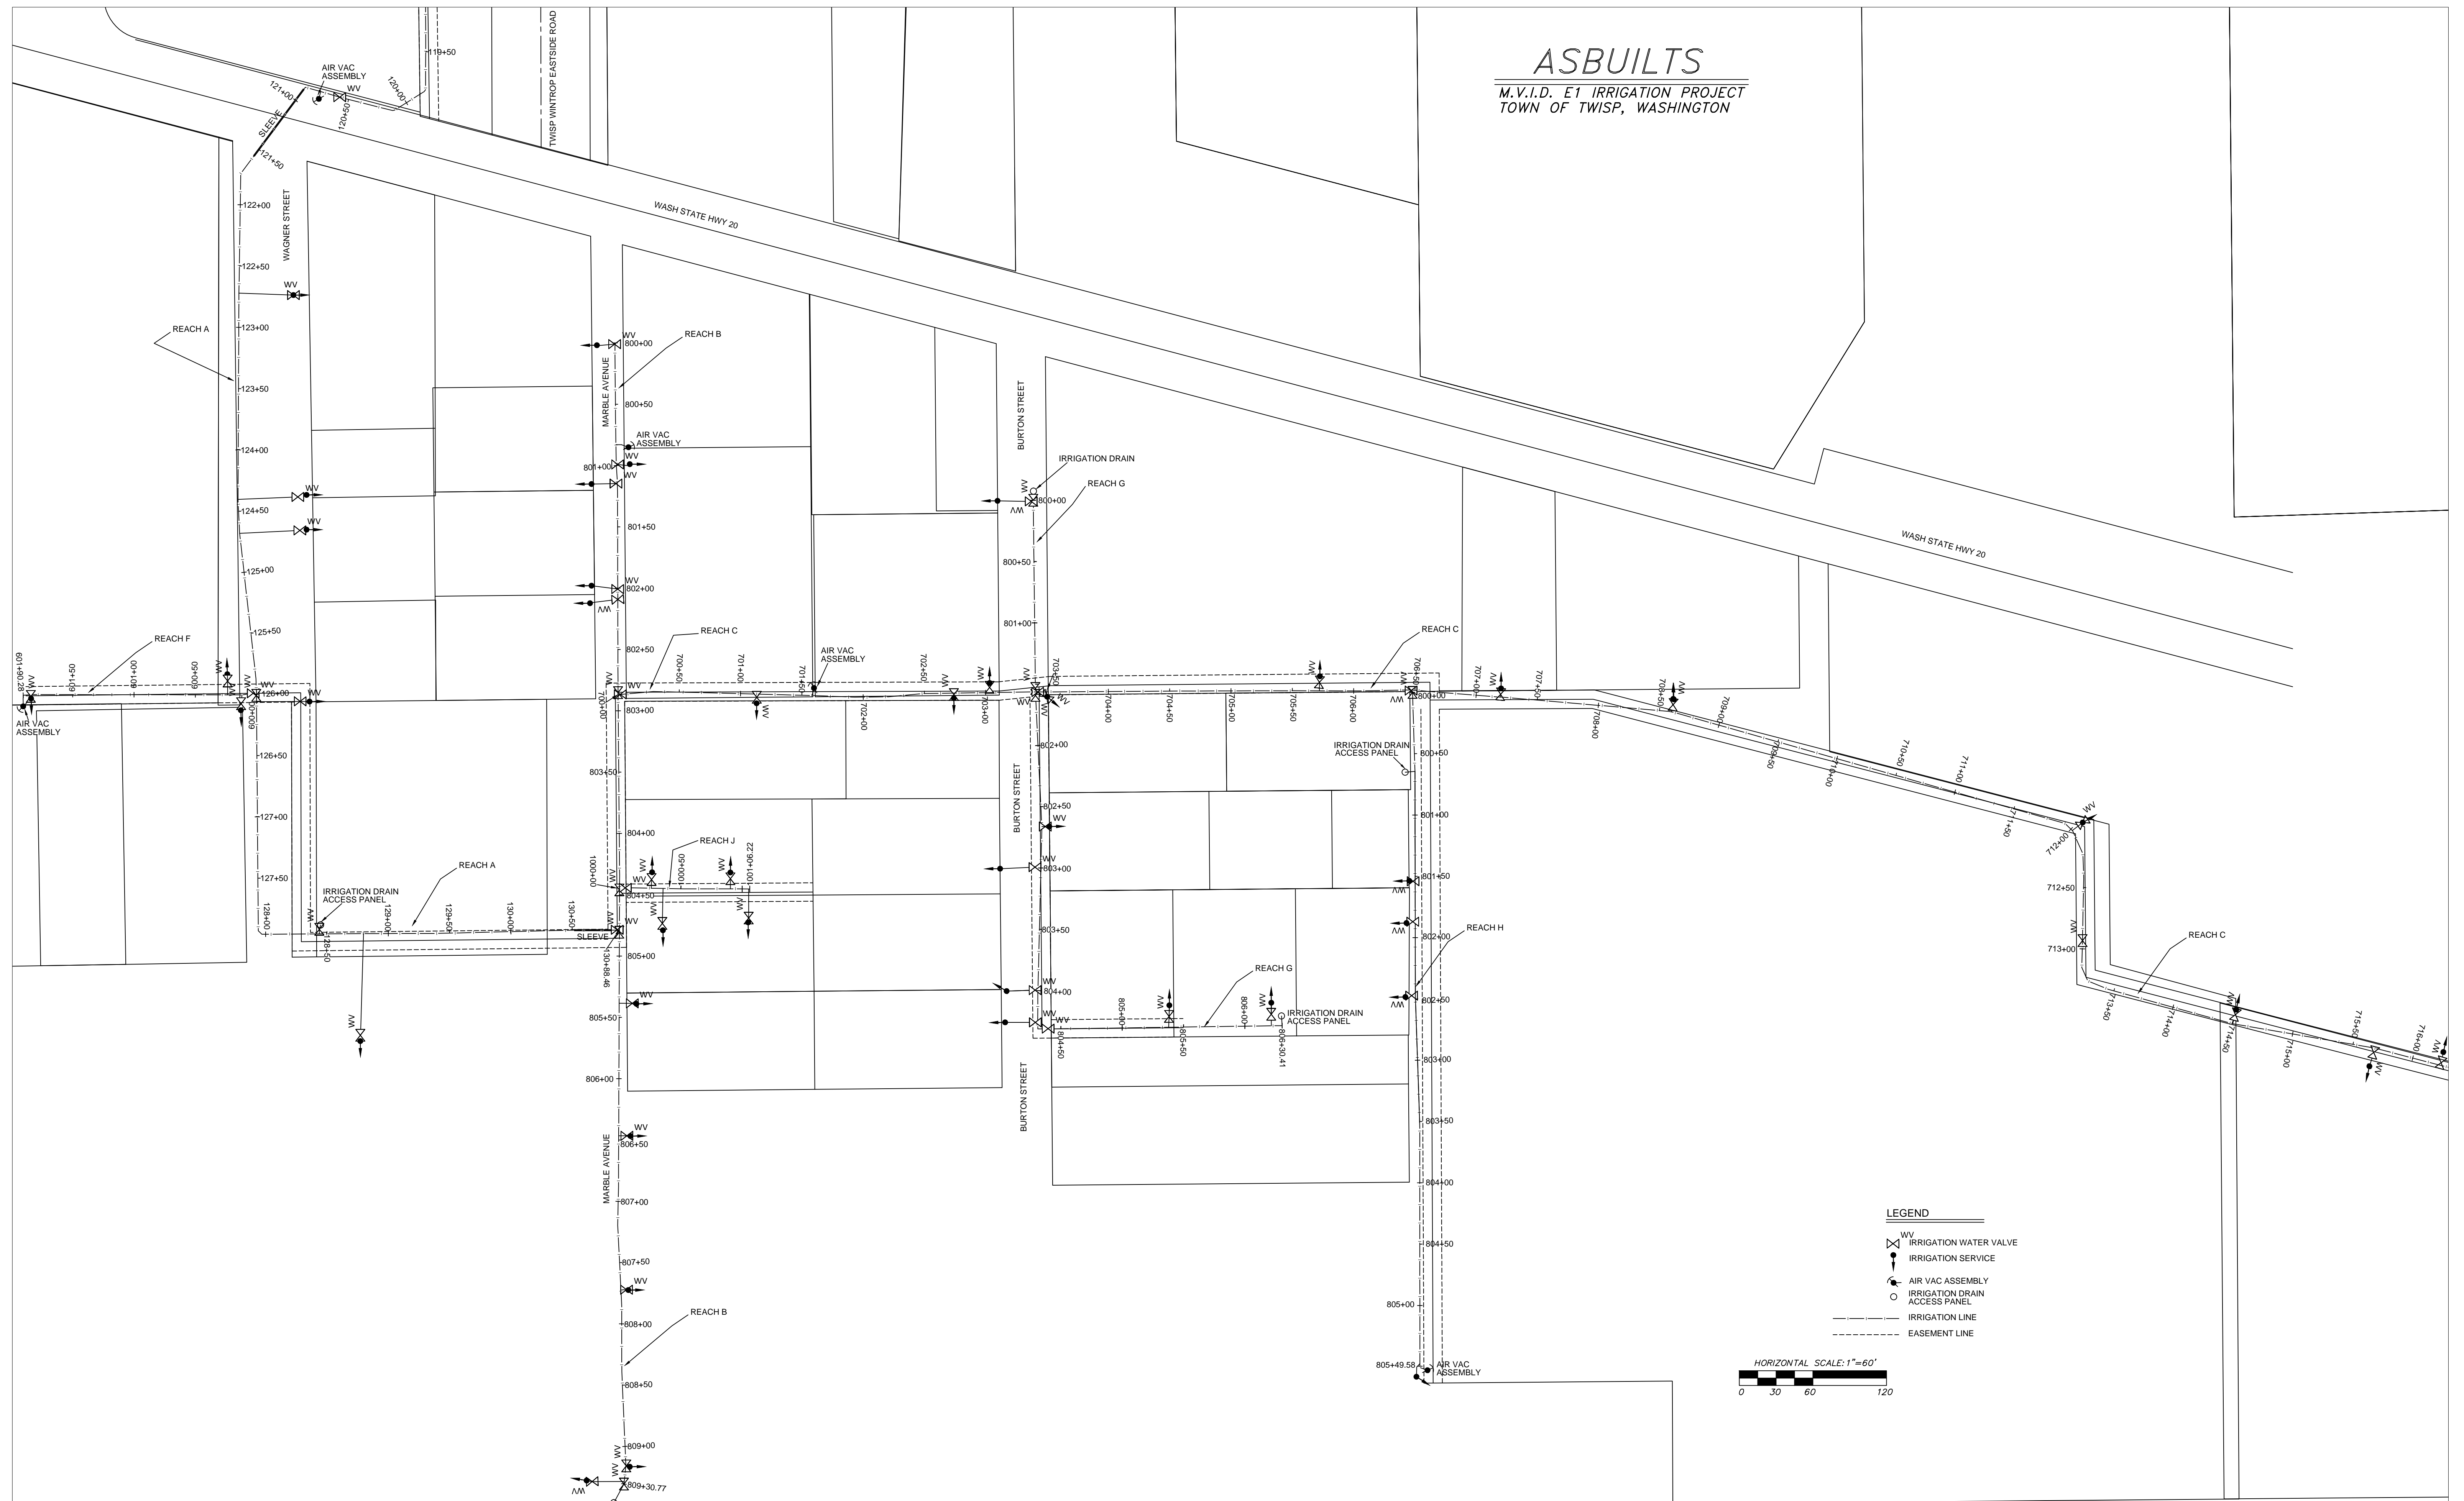

**LEGEND**  
WV IRRIGATION WATER VALVE  
↑ IRRIGATION SERVICE  
AIR VAC ASSEMBLY  
O IRRIGATION DRAIN ACCESS PANEL  
--- IRRIGATION LINE  
- - - - - EASEMENT LINE

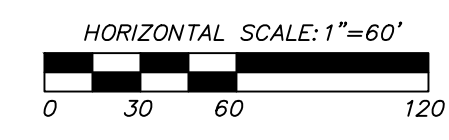


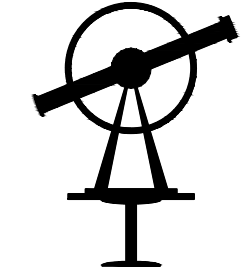
	<b>TACKMAN SURVEYING</b> LAND SURVEYING - CONSTRUCTION LAYOUT LAND DEVELOPMENT		SHT 2 OF 3
	1112 HWY. 20 P.O. BOX 631 WINTHROP, WA. 98862 PH. (509) 996.3409		
CLIENT: LLOYD LOGGING DATE: 03/18/2016 SCALE: 1"=60'	DWG: E1 PIPELINE ASBUILTS PROJECT: 15-111		

**ASBUILTS**  
M.V.I.D. E1 IRRIGATION PROJECT  
TOWN OF TWISP, WASHINGTON




- LEGEND**
- WV IRRIGATION WATER VALVE
  - ↑ IRRIGATION SERVICE
  - ⊗ AIR VAC ASSEMBLY
  - IRRIGATION DRAIN ACCESS PANEL
  - IRRIGATION LINE
  - - - EASEMENT LINE

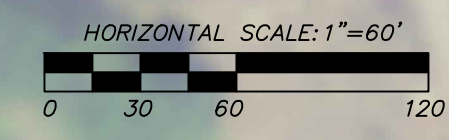

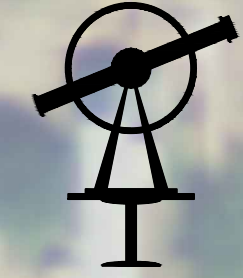
	<b>TACKMAN SURVEYING</b>		SHT 2 OF 3
	LAND SURVEYING - CONSTRUCTION LAYOUT LAND DEVELOPMENT 1112 HWY. 20 P.O. BOX 631 WINTHROP, WA. 98862 PH. (509) 996.3409		
CLIENT: LLOYD LOGGING	DWG: E1 PIPELINE ASBUILTS		
DATE: 03/18/2016	PROJECT: 15-111		
SCALE: 1"=60'			

# ASBUILTS

M.V.I.D. E1 IRRIGATION PROJECT  
TOWN OF TWISP, WASHINGTON

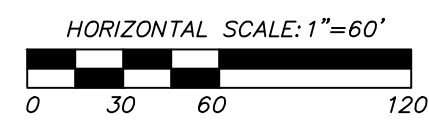

- IRRIGATION WATER VALVE
- IRRIGATION SERVICE
- AIR VAC ASSEMBLY
- IRRIGATION DRAIN ACCESS PANEL
- IRRIGATION LINE
- EASEMENT LINE

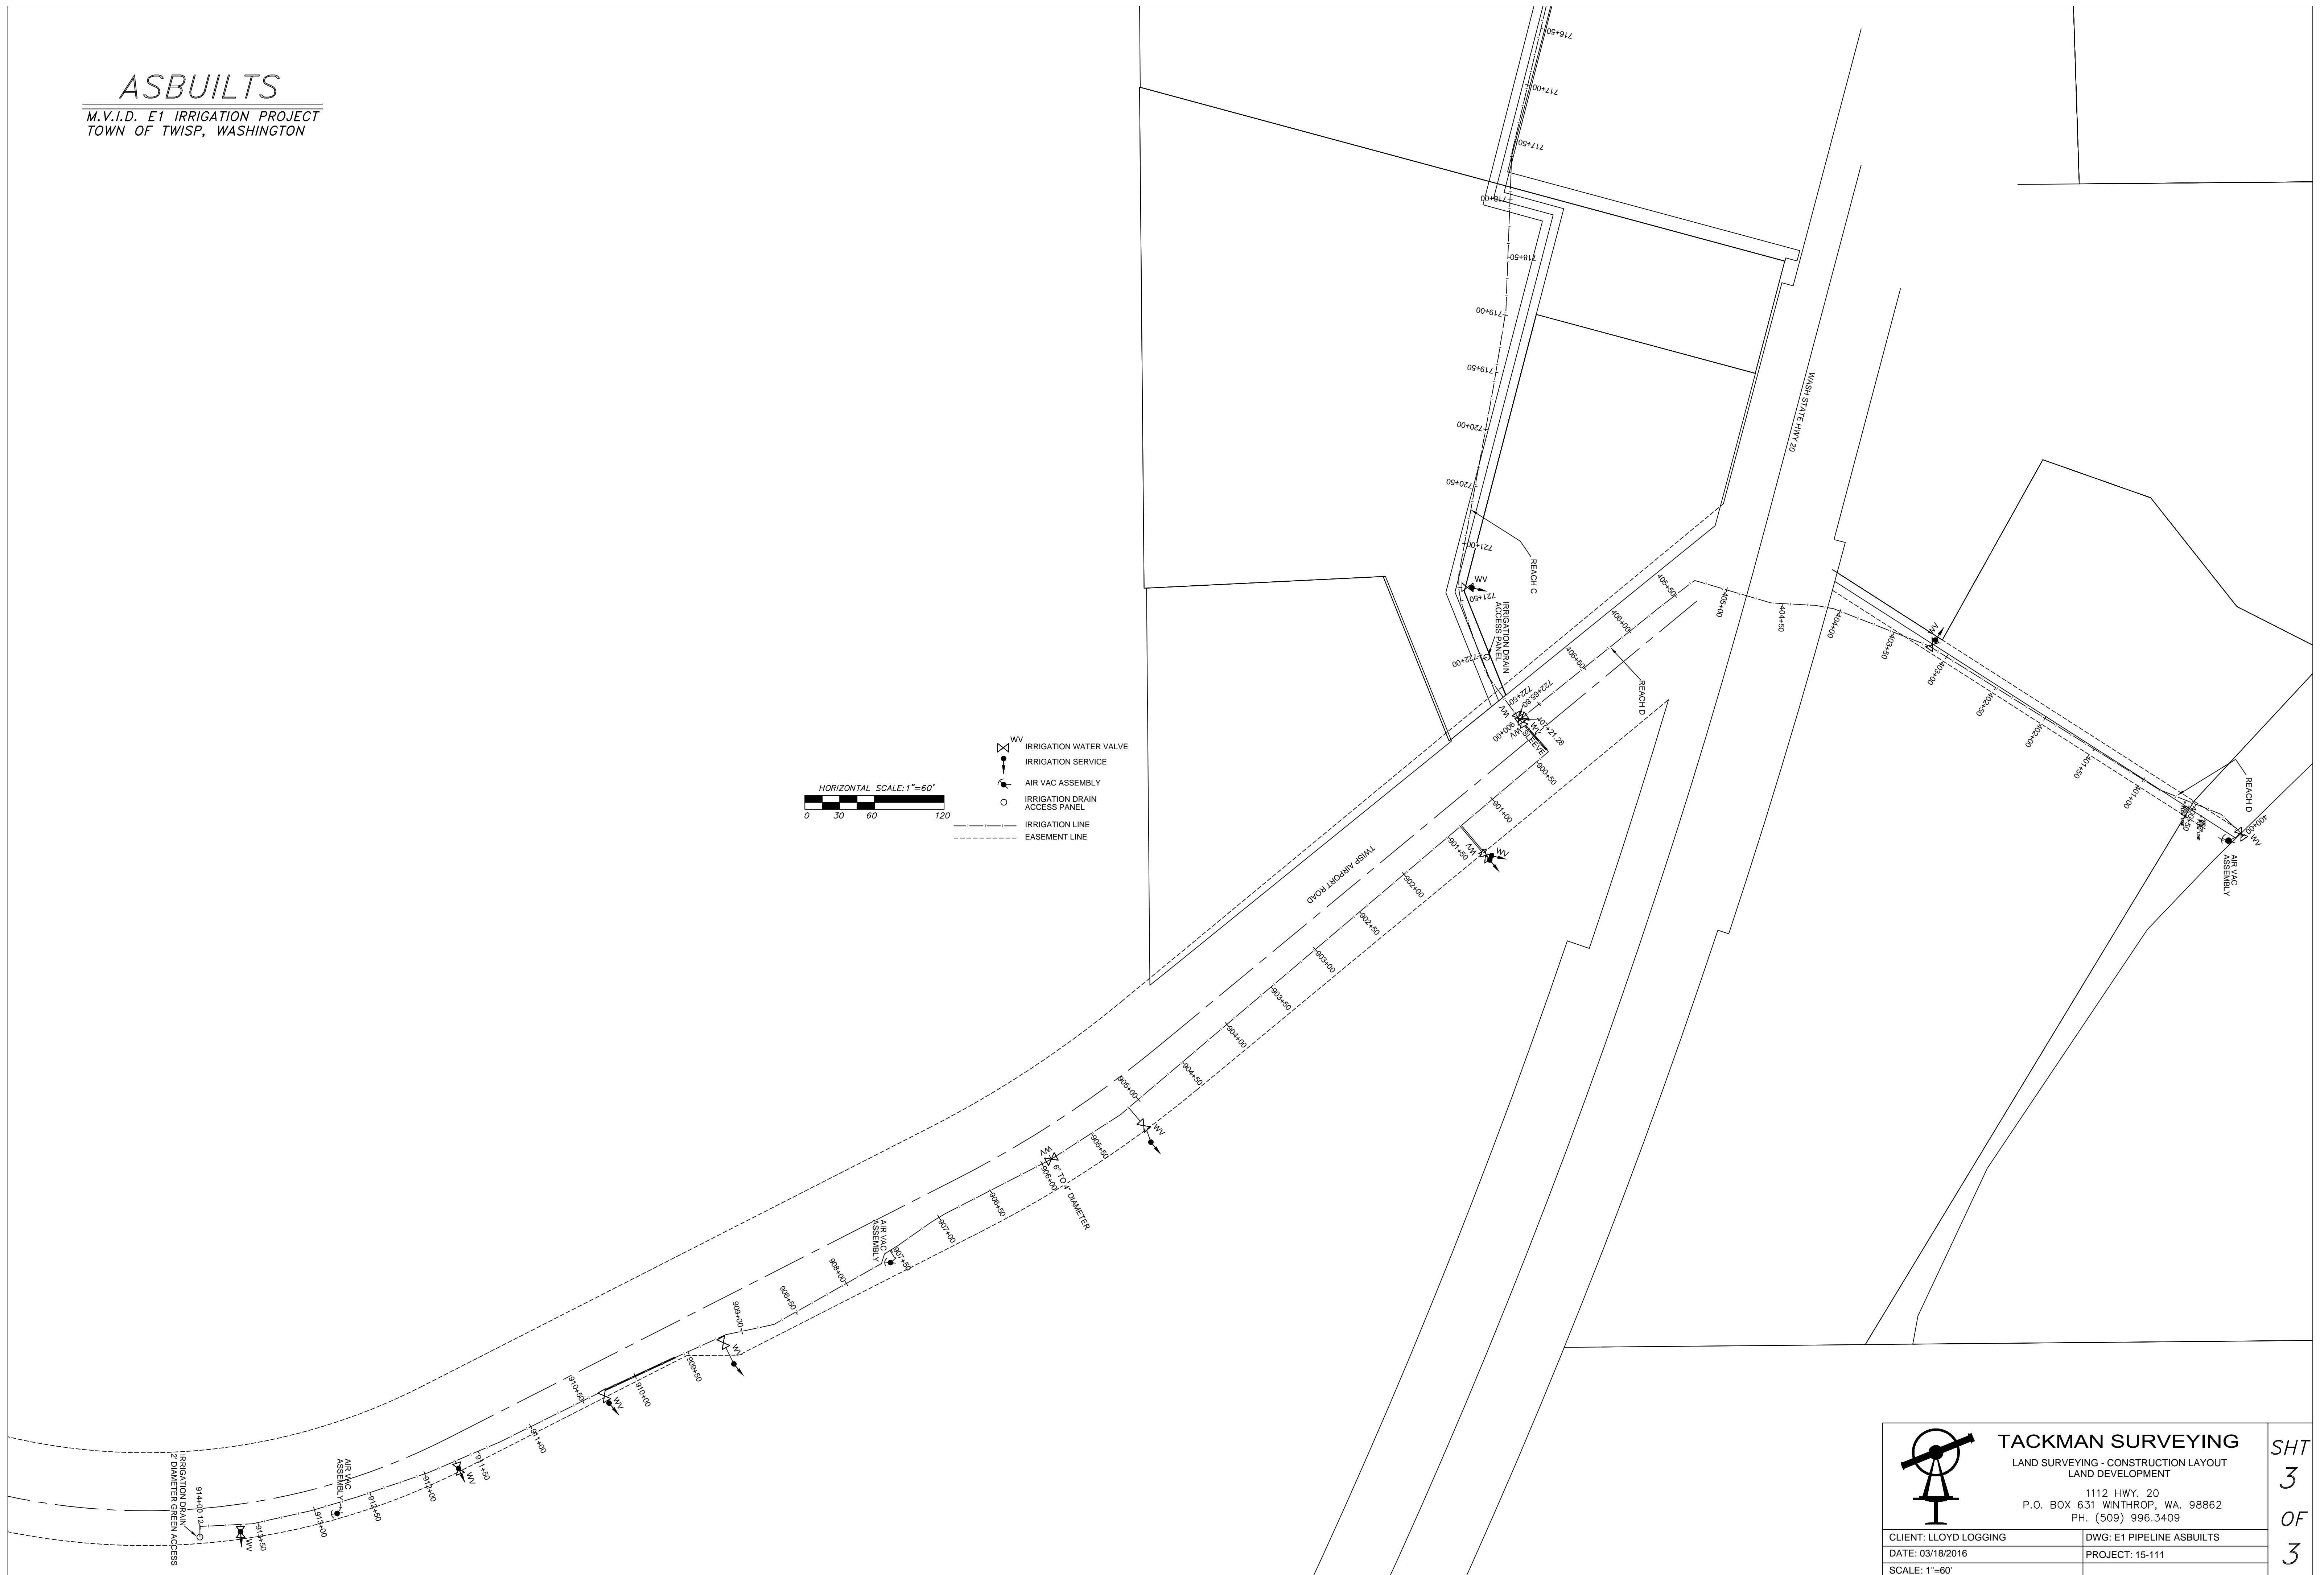


	<b>TACKMAN SURVEYING</b>
	LAND SURVEYING - CONSTRUCTION LAYOUT LAND DEVELOPMENT
	1112 HWY. 20 P.O. BOX 631 WINTHROP, WA. 98862 PH. (509) 996.3409
CLIENT: LLOYD LOGGING	DWG: E1 PIPELINE ASBUILTS
DATE: 03/18/2016	PROJECT: 15-111
SCALE: 1"=60'	

SHT  
3  
OF  
3

# ASBUILTS

M.V.I.D. E1 IRRIGATION PROJECT  
TOWN OF TWISP, WASHINGTON

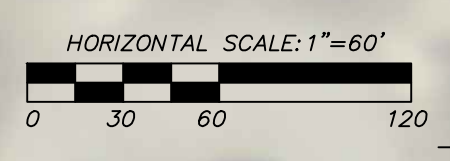

- IRRIGATION WATER VALVE
- IRRIGATION SERVICE
- AIR VAC ASSEMBLY
- IRRIGATION DRAIN ACCESS PANEL
- IRRIGATION LINE
- EASEMENT LINE



	<b>TACKMAN SURVEYING</b>	
	LAND SURVEYING - CONSTRUCTION LAYOUT LAND DEVELOPMENT	
	1112 HWY. 20 P.O. BOX 631 WINTHROP, WA. 98862 PH. (509) 996.3409	
	CLIENT: LLOYD LOGGING	DWG: E1 PIPELINE ASBUILTS
DATE: 03/18/2016	PROJECT: 15-111	
SCALE: 1"=60'		

SHT  
3  
OF  
3