
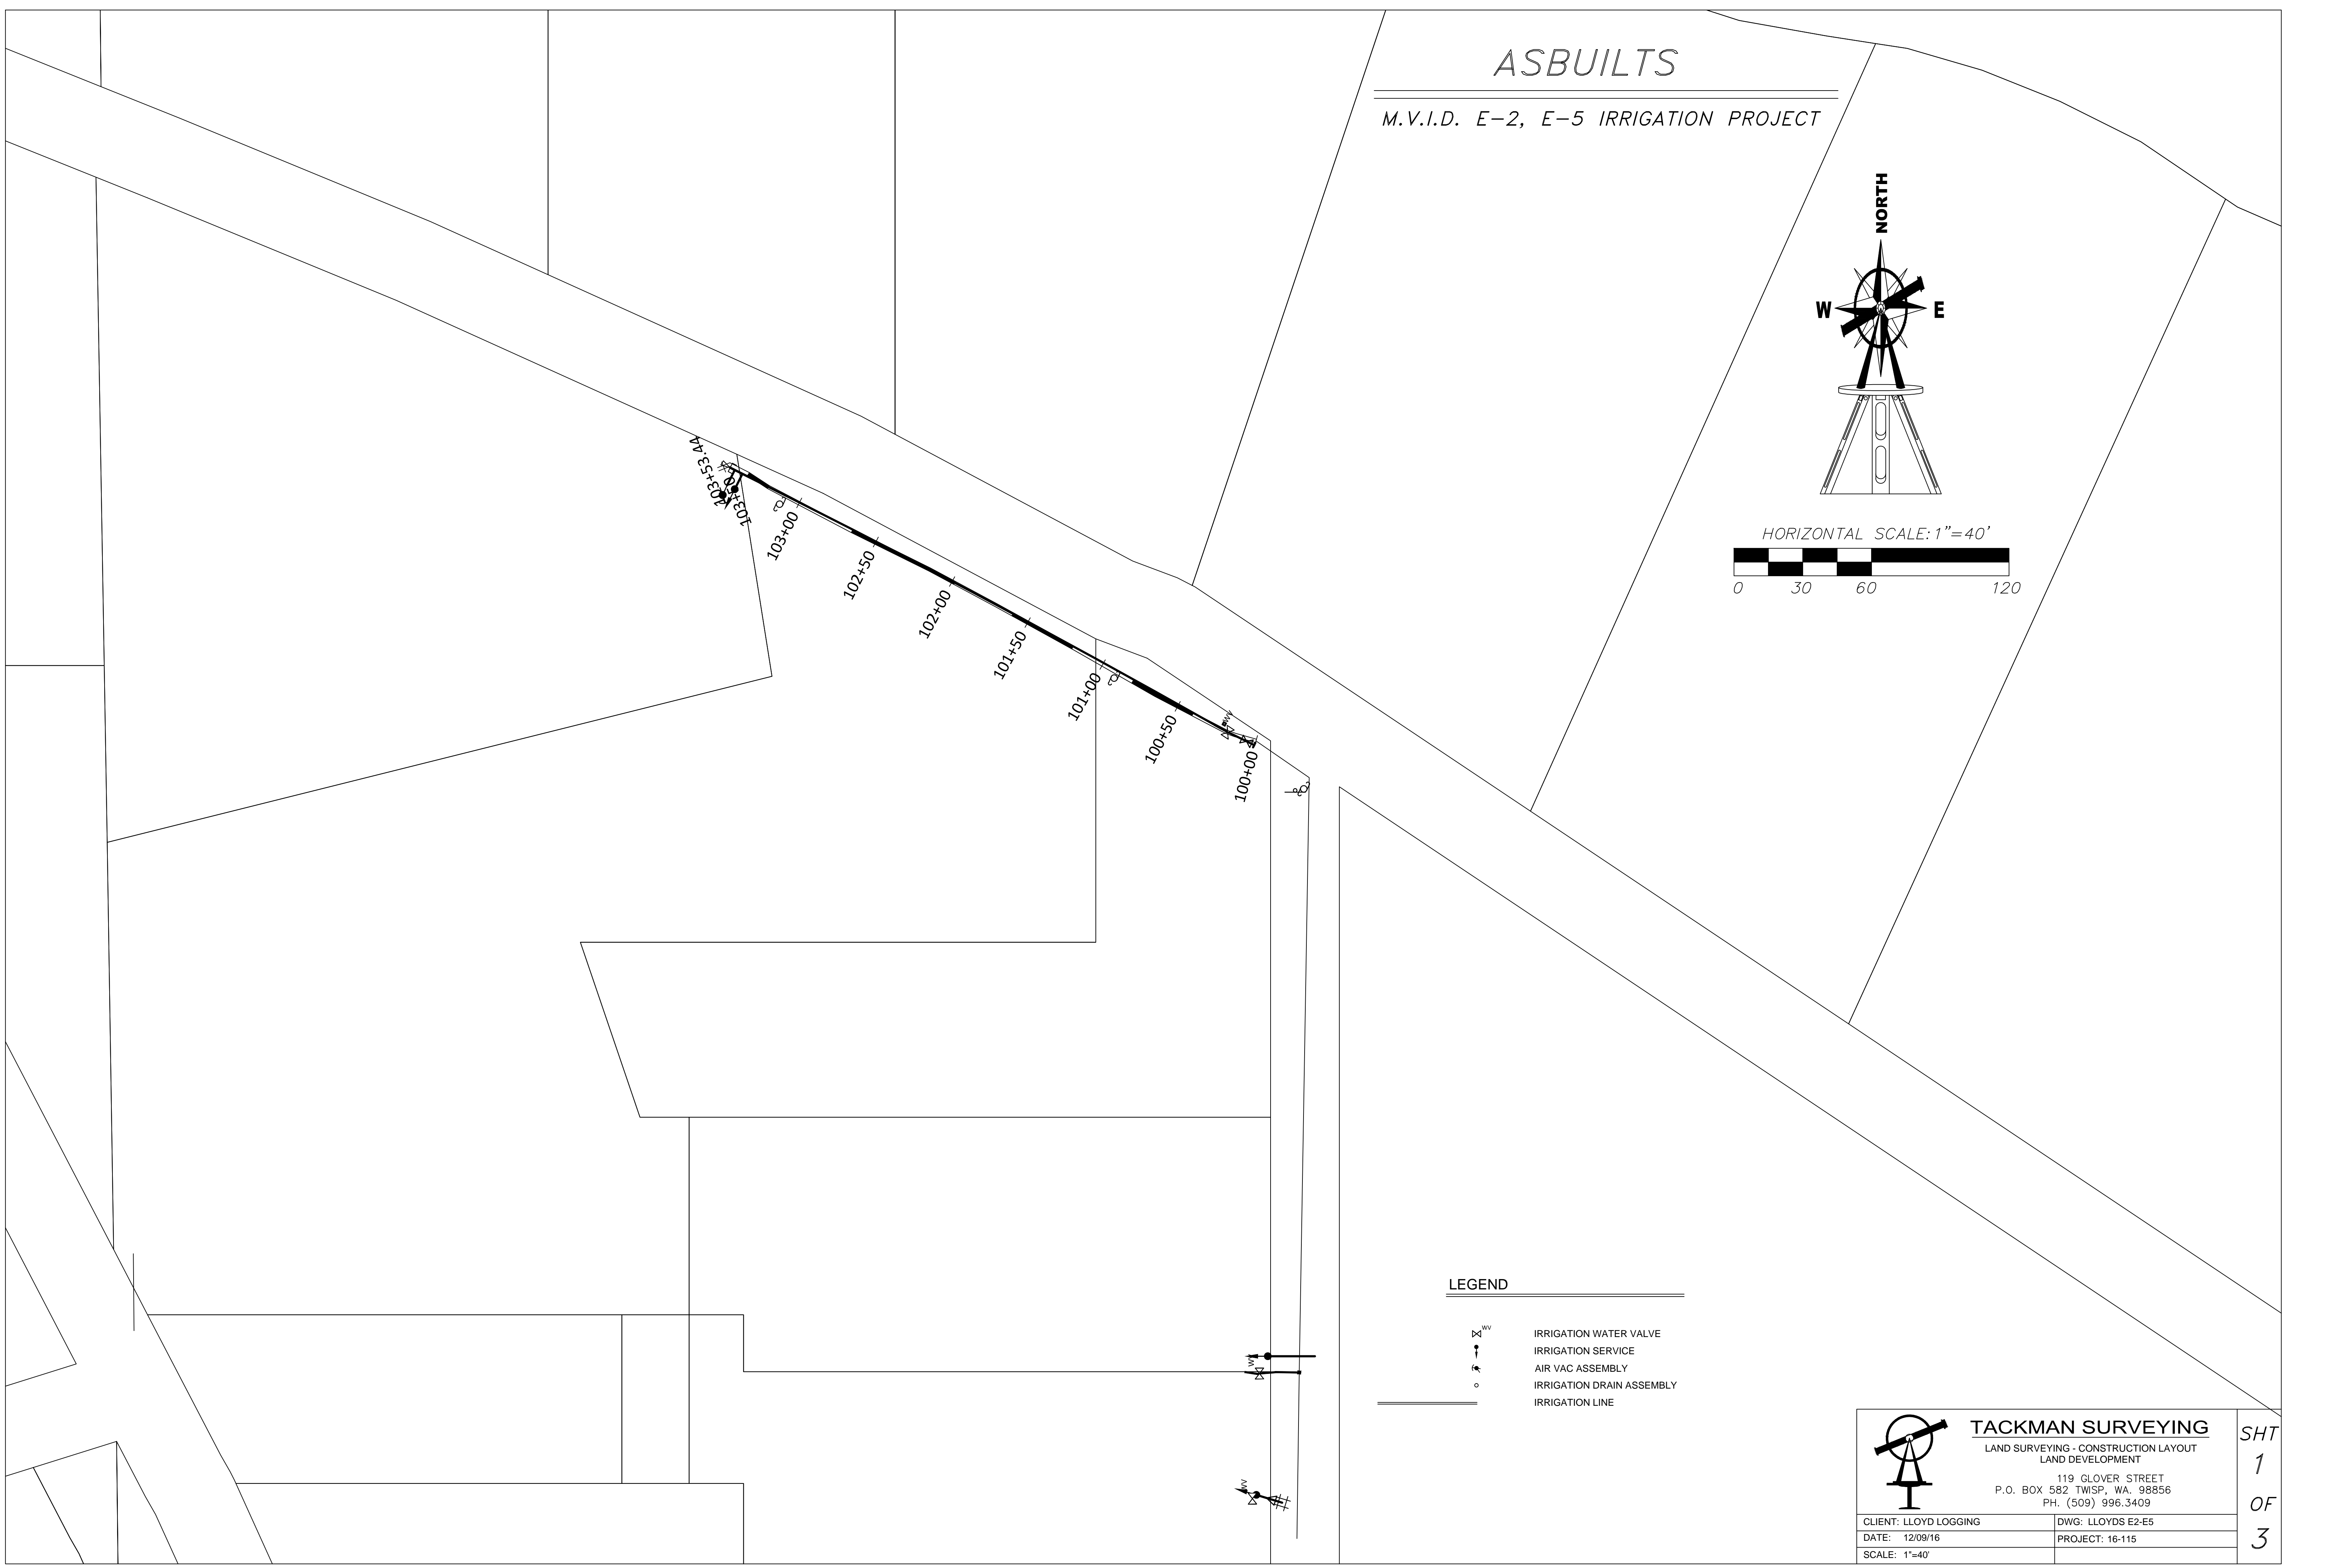
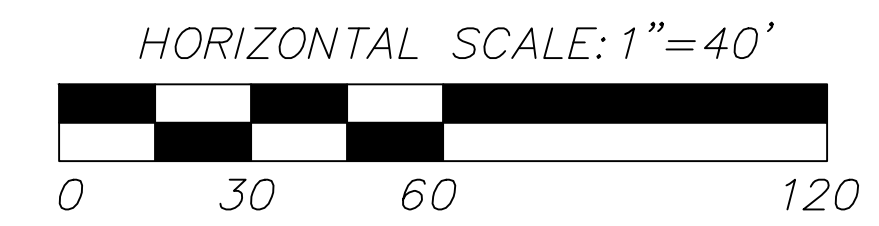


ASBUILTS

M.V.I.D. E-2, E-5 IRRIGATION PROJECT

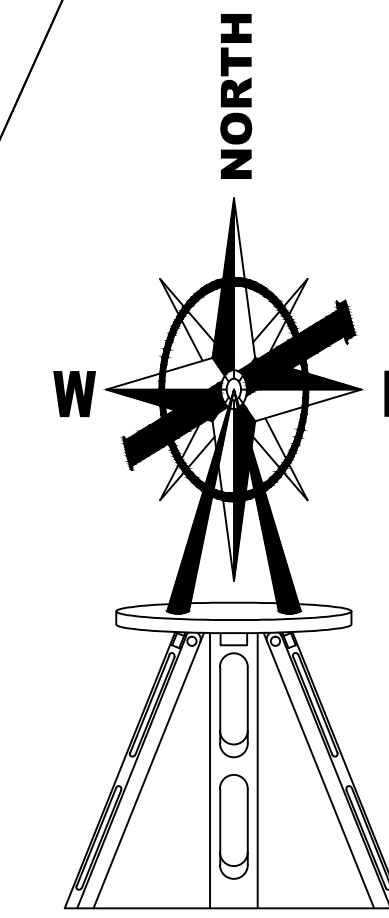



LEGEND

- IRRIGATION WATER VALVE
- IRRIGATION SERVICE
- AIR VAC ASSEMBLY
- IRRIGATION DRAIN ASSEMBLY
- IRRIGATION LINE

	TACKMAN SURVEYING	SHT 1 OF 3
	LAND SURVEYING - CONSTRUCTION LAYOUT LAND DEVELOPMENT	
119 GLOVER STREET P.O. BOX 582 TWISP, WA. 98856 PH. (509) 996.3409		
CLIENT: LLOYD LOGGING	DWG: LLOYDS E2-E5	
DATE: 12/09/16	PROJECT: 16-115	
SCALE: 1"=40'		

ASBUILTS

M.V.I.D. E-2, E-5 IRRIGATION PROJECT

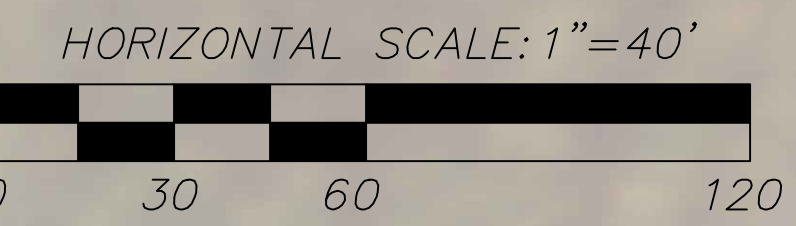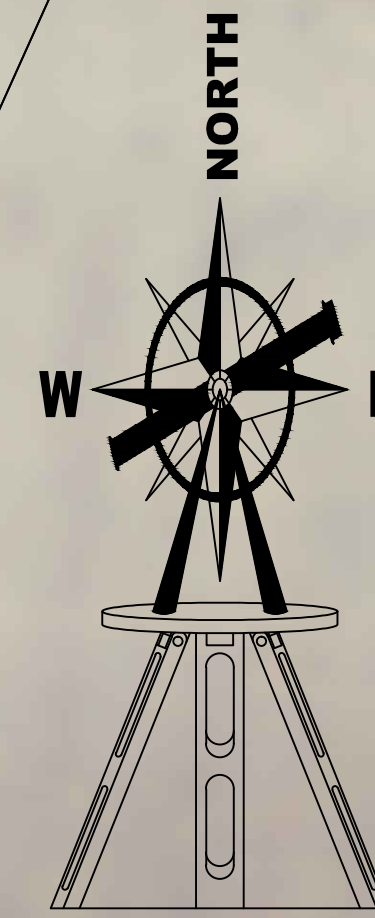


LEGEND

- IRRIGATION WATER VALVE
- IRRIGATION SERVICE
- AIR VAC ASSEMBLY
- IRRIGATION DRAIN ASSEMBLY
- IRRIGATION LINE

	TACKMAN SURVEYING		SHT 1 OF 3
	LAND SURVEYING - CONSTRUCTION LAYOUT LAND DEVELOPMENT		
119 GLOVER STREET P.O. BOX 582 TWISP, WA. 98856 PH. (509) 996.3409			
CLIENT: LLOYD LOGGING	DWG: LLOYDS E2-E5		
DATE: 12/09/16	PROJECT: 16-115		
SCALE: 1"=40'			

ASBUILTS


M.V.I.D. E-2, E-5 IRRIGATION PROJECT

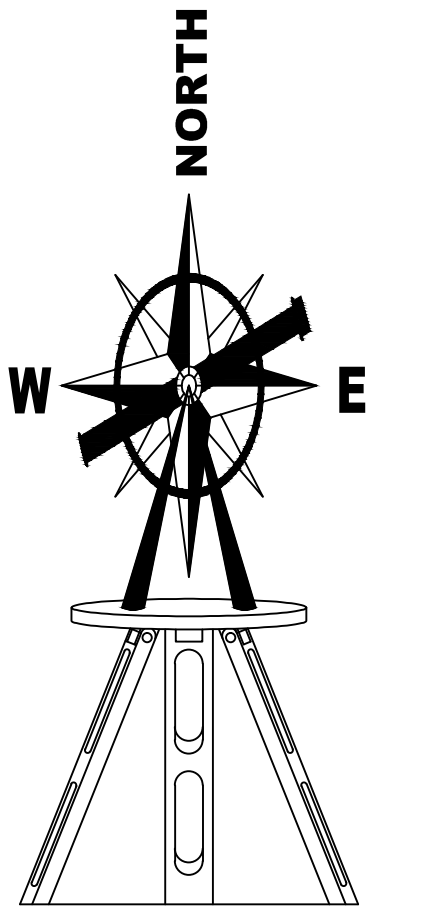

HORIZONTAL SCALE: 1"=80'
0 40 80 160

LEGEND


- IRRIGATION WATER VALVE
- IRRIGATION SERVICE
- AIR VAC ASSEMBLY
- IRRIGATION DRAIN ASSEMBLY
- IRRIGATION LINE

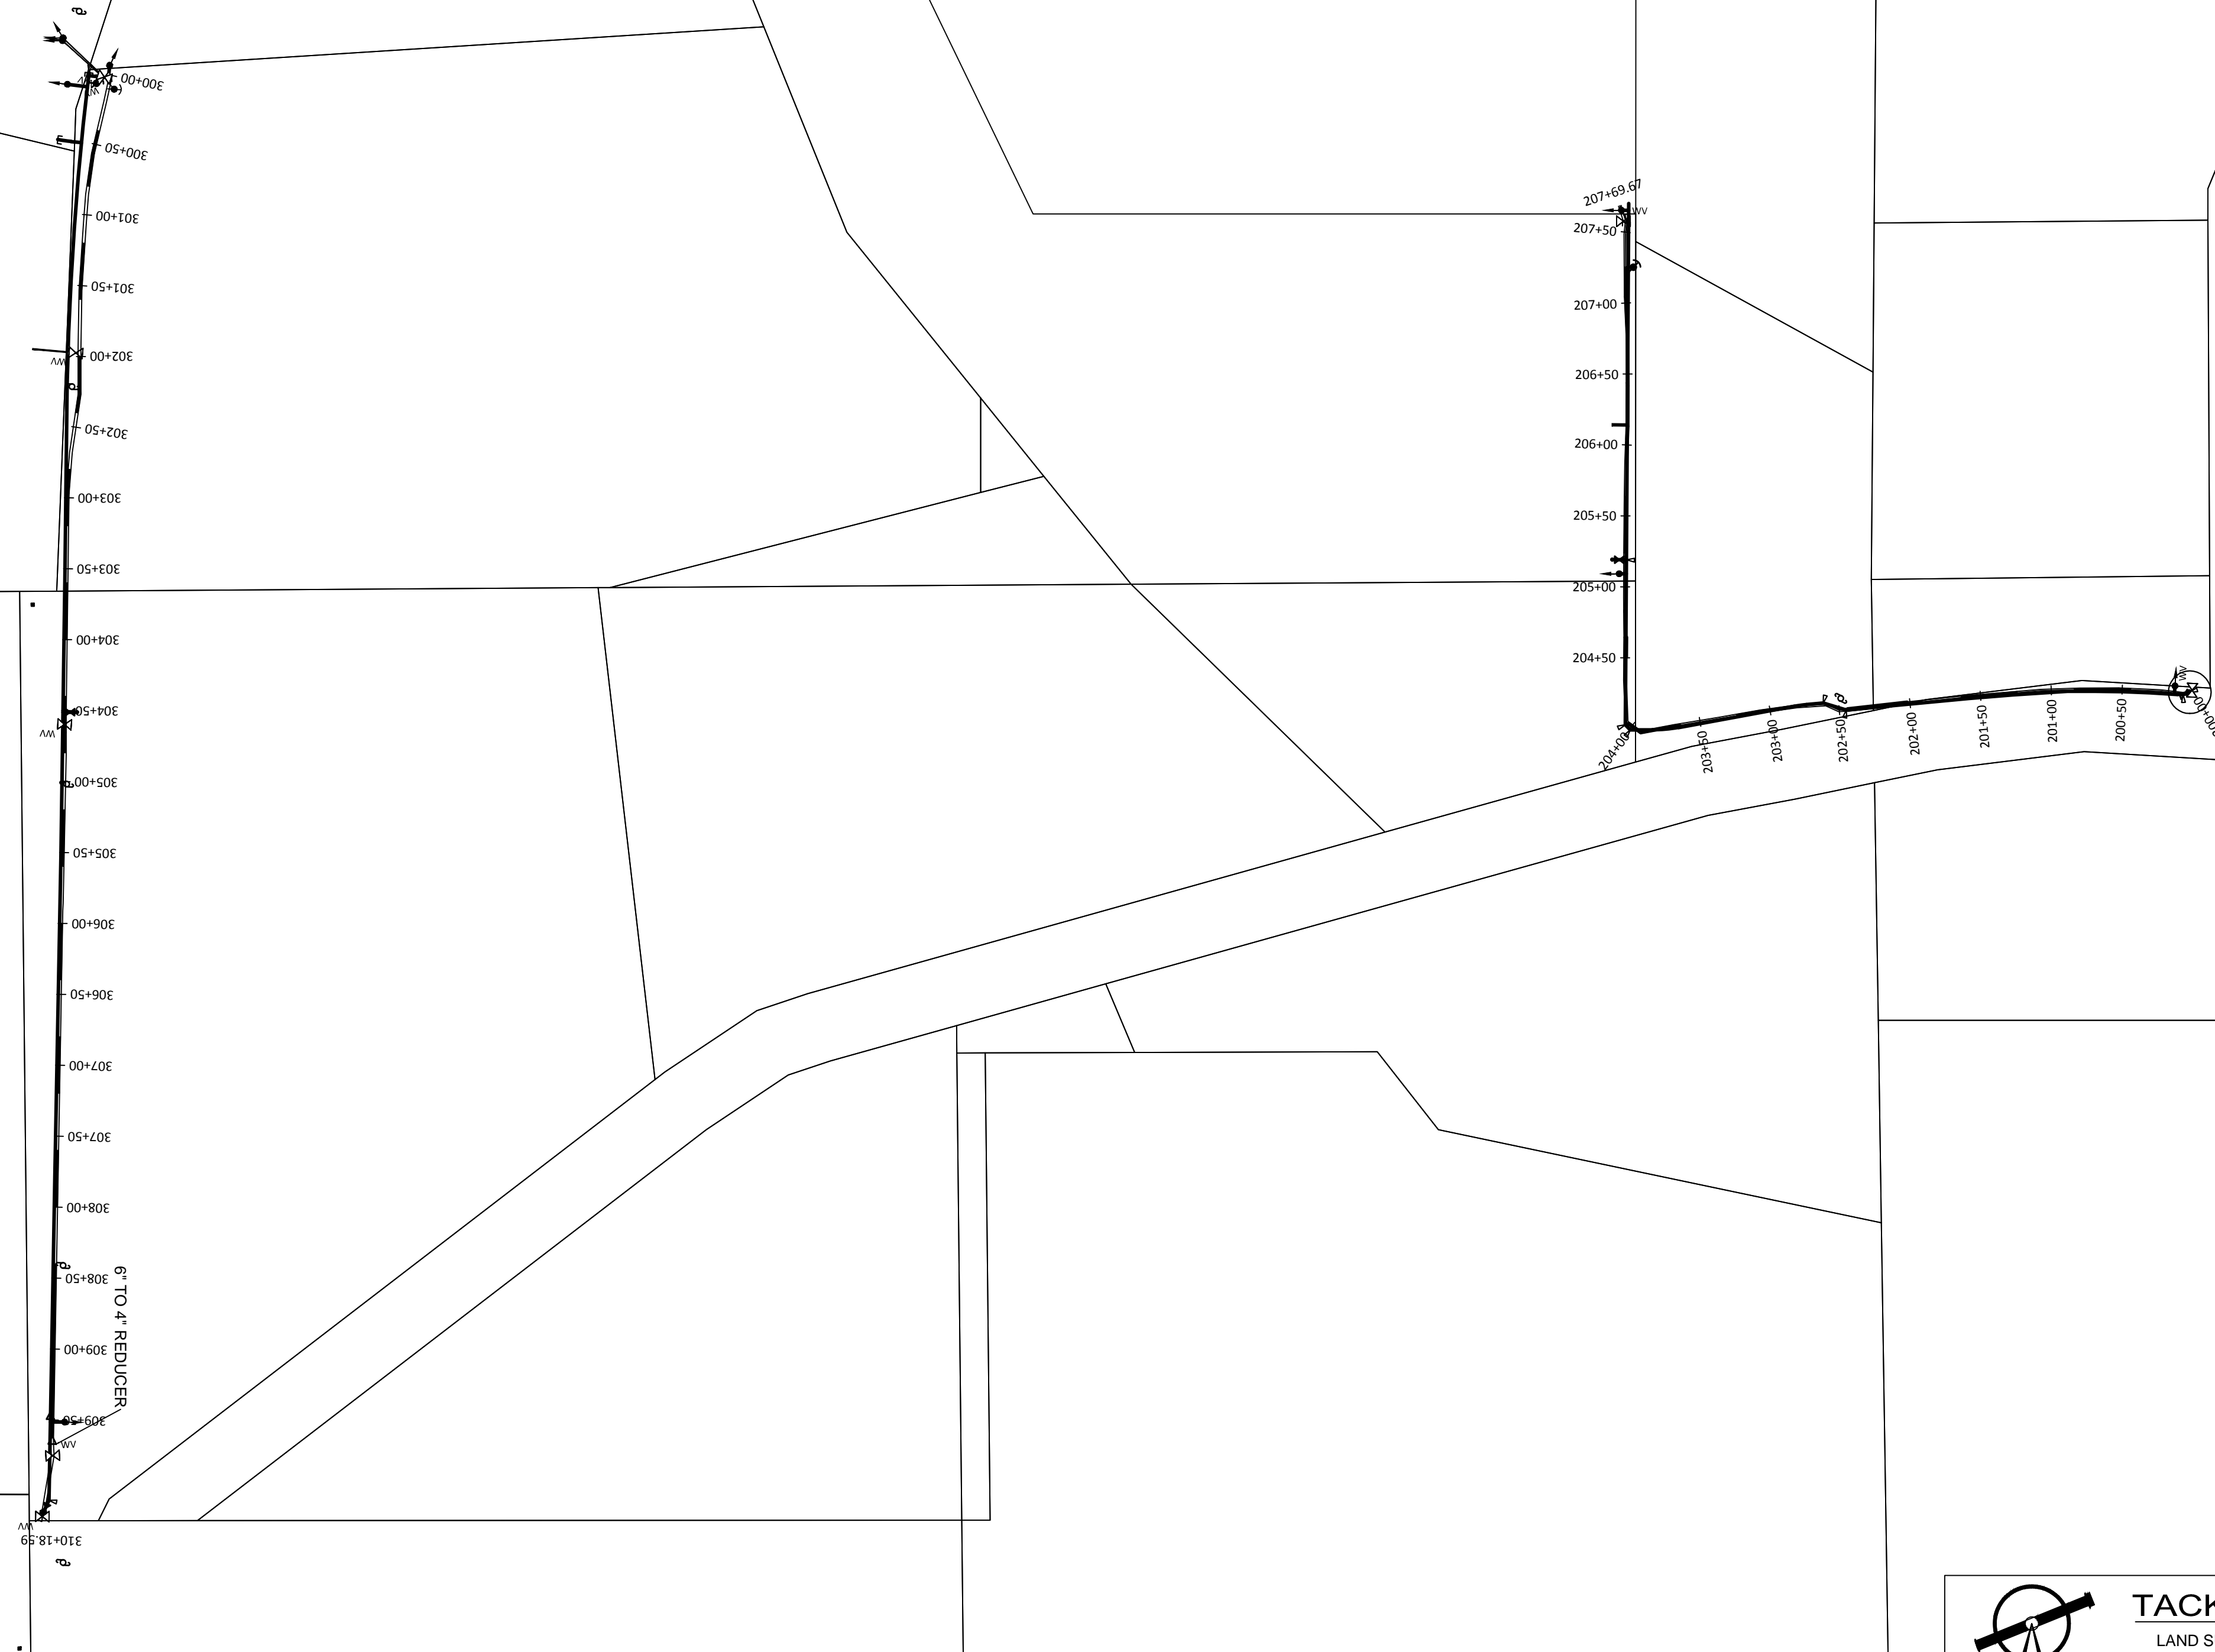

	TACKMAN SURVEYING		SHT 2 OF 3
	LAND SURVEYING - CONSTRUCTION LAYOUT LAND DEVELOPMENT		
119 GLOVER STREET P.O. BOX 582 TWISP, WA. 98856 PH. (509) 996.3409			
CLIENT: LLOYD LOGGING	DWG: LLOYDS E2-E5		
DATE: 12/09/16	PROJECT: 16-115		
SCALE: 1"=80'			

ASBUILTS

M.V.I.D. E-2, E-5 IRRIGATION PROJECT

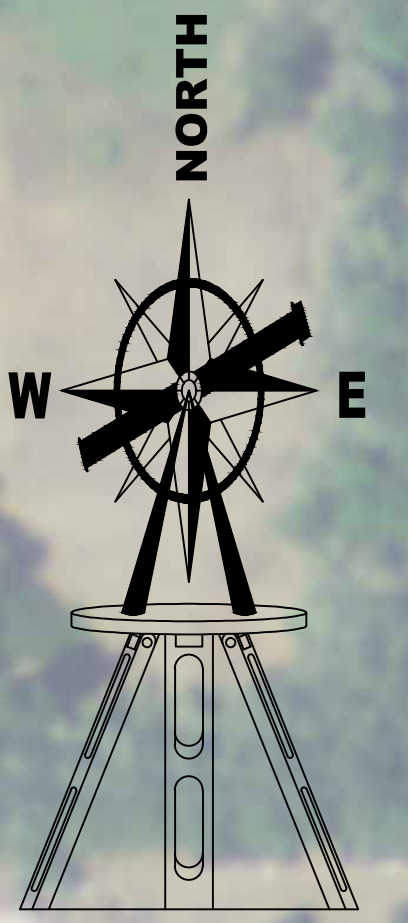

HORIZONTAL SCALE: 1"=80'
0 40 80 160

LEGEND



IRRIGATION WATER VALVE



IRRIGATION SERVICE



AIR VAC ASSEMBLY



IRRIGATION DRAIN ASSEMBLY




IRRIGATION LINE




	TACKMAN SURVEYING	SHT 2 OF 3
	LAND SURVEYING - CONSTRUCTION LAYOUT LAND DEVELOPMENT	
119 CLOVER STREET P.O. BOX 582 TWISP, WA, 98856 PH. (509) 996.3409		
CLIENT: LLOYD LOGGING	DWG: LLOYDS E2-E5	
DATE: 12/09/16	PROJECT: 16-115	
SCALE: 1"=80'		

ASBUILTS

M.V.I.D. E-2, E-5 IRRIGATION PROJECT

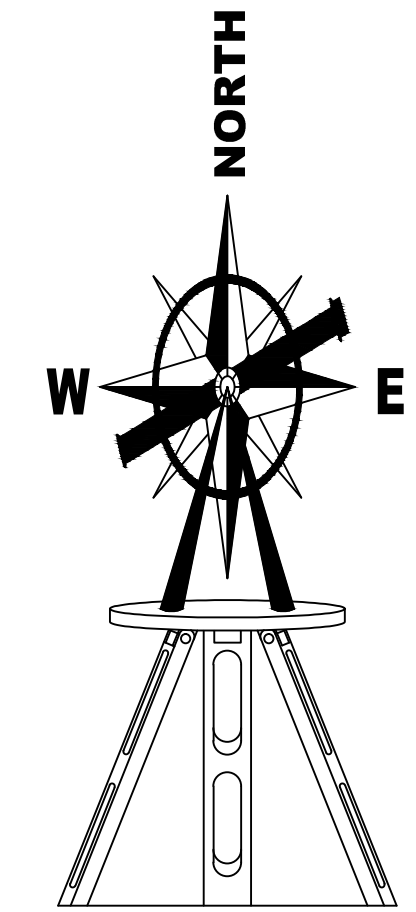

HORIZONTAL SCALE: 1"=80'
0 40 80 160

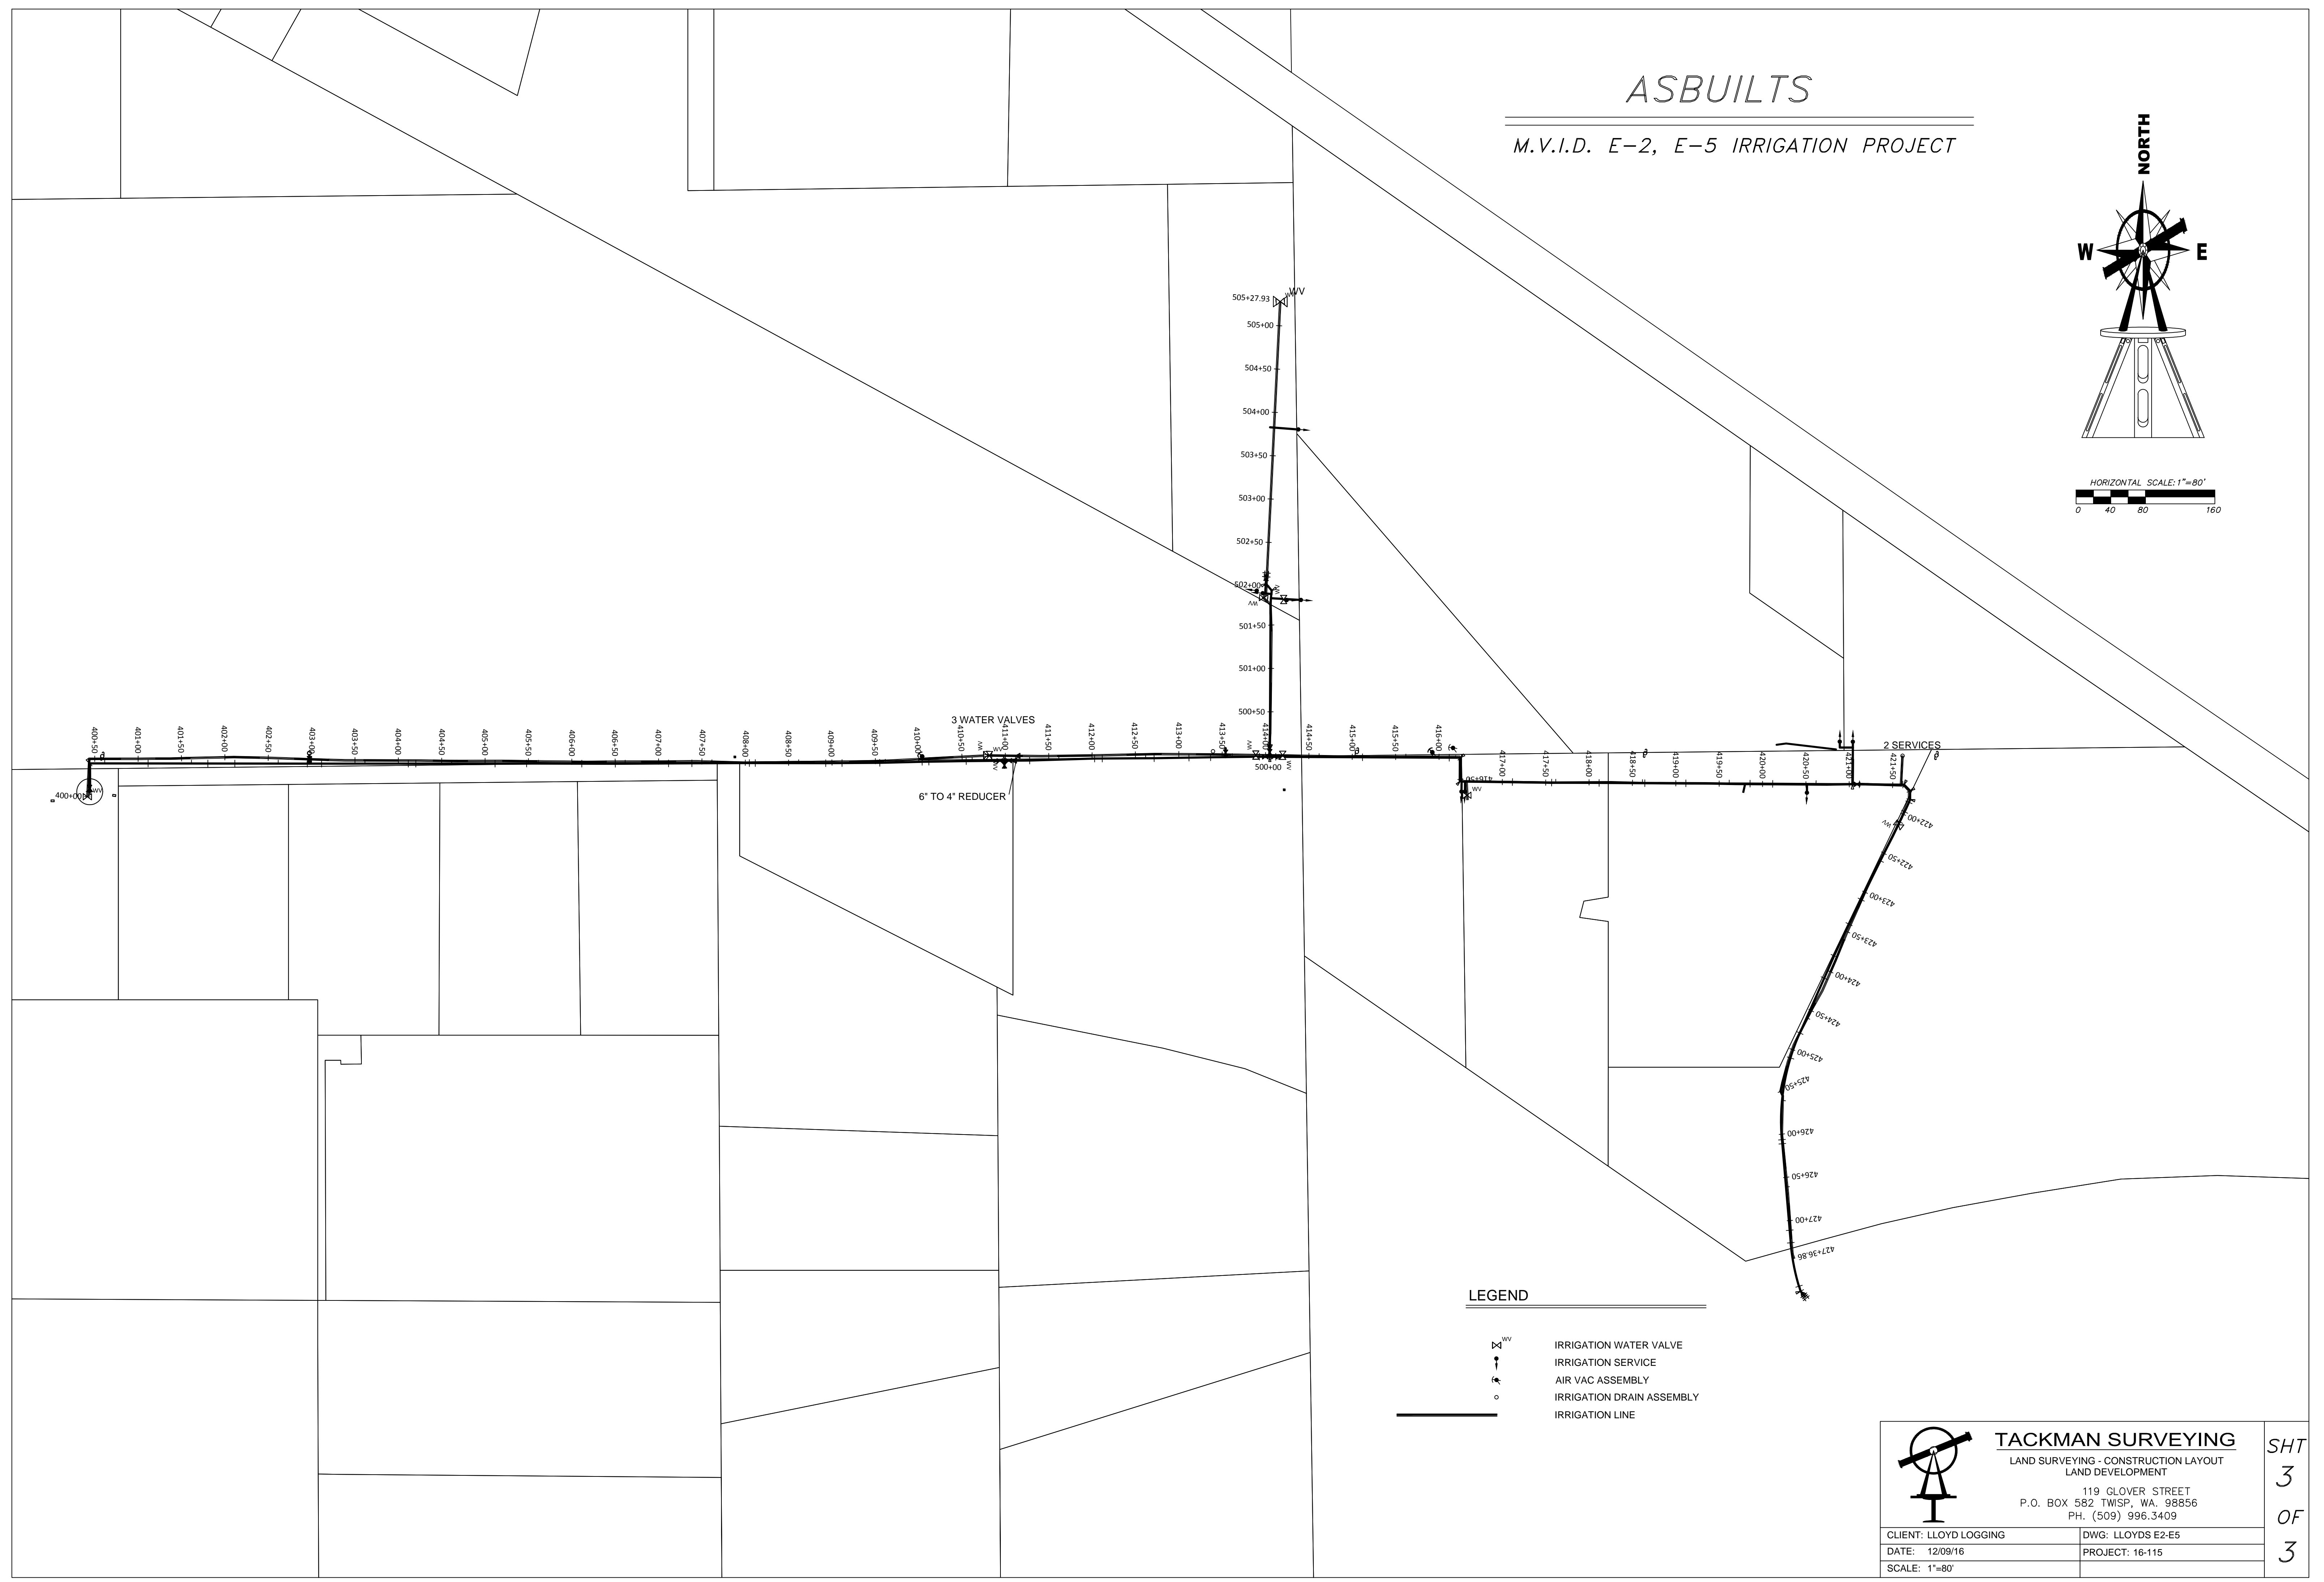

LEGEND



- IRRIGATION WATER VALVE
- IRRIGATION SERVICE
- AIR VAC ASSEMBLY
- IRRIGATION DRAIN ASSEMBLY
- IRRIGATION LINE

	TACKMAN SURVEYING	
	LAND SURVEYING - CONSTRUCTION LAYOUT LAND DEVELOPMENT	
119 GLOVER STREET P.O. BOX 582 TWISP, WA. 98856 PH. (509) 996.3409		
CLIENT: LLOYD LOGGING	DWG: LLOYDS E2-E5	
DATE: 12/09/16	PROJECT: 16-115	
SCALE: 1"=80'		

SHT
3
OF
3

ASBUILTS

M.V.I.D. E-2, E-5 IRRIGATION PROJECT

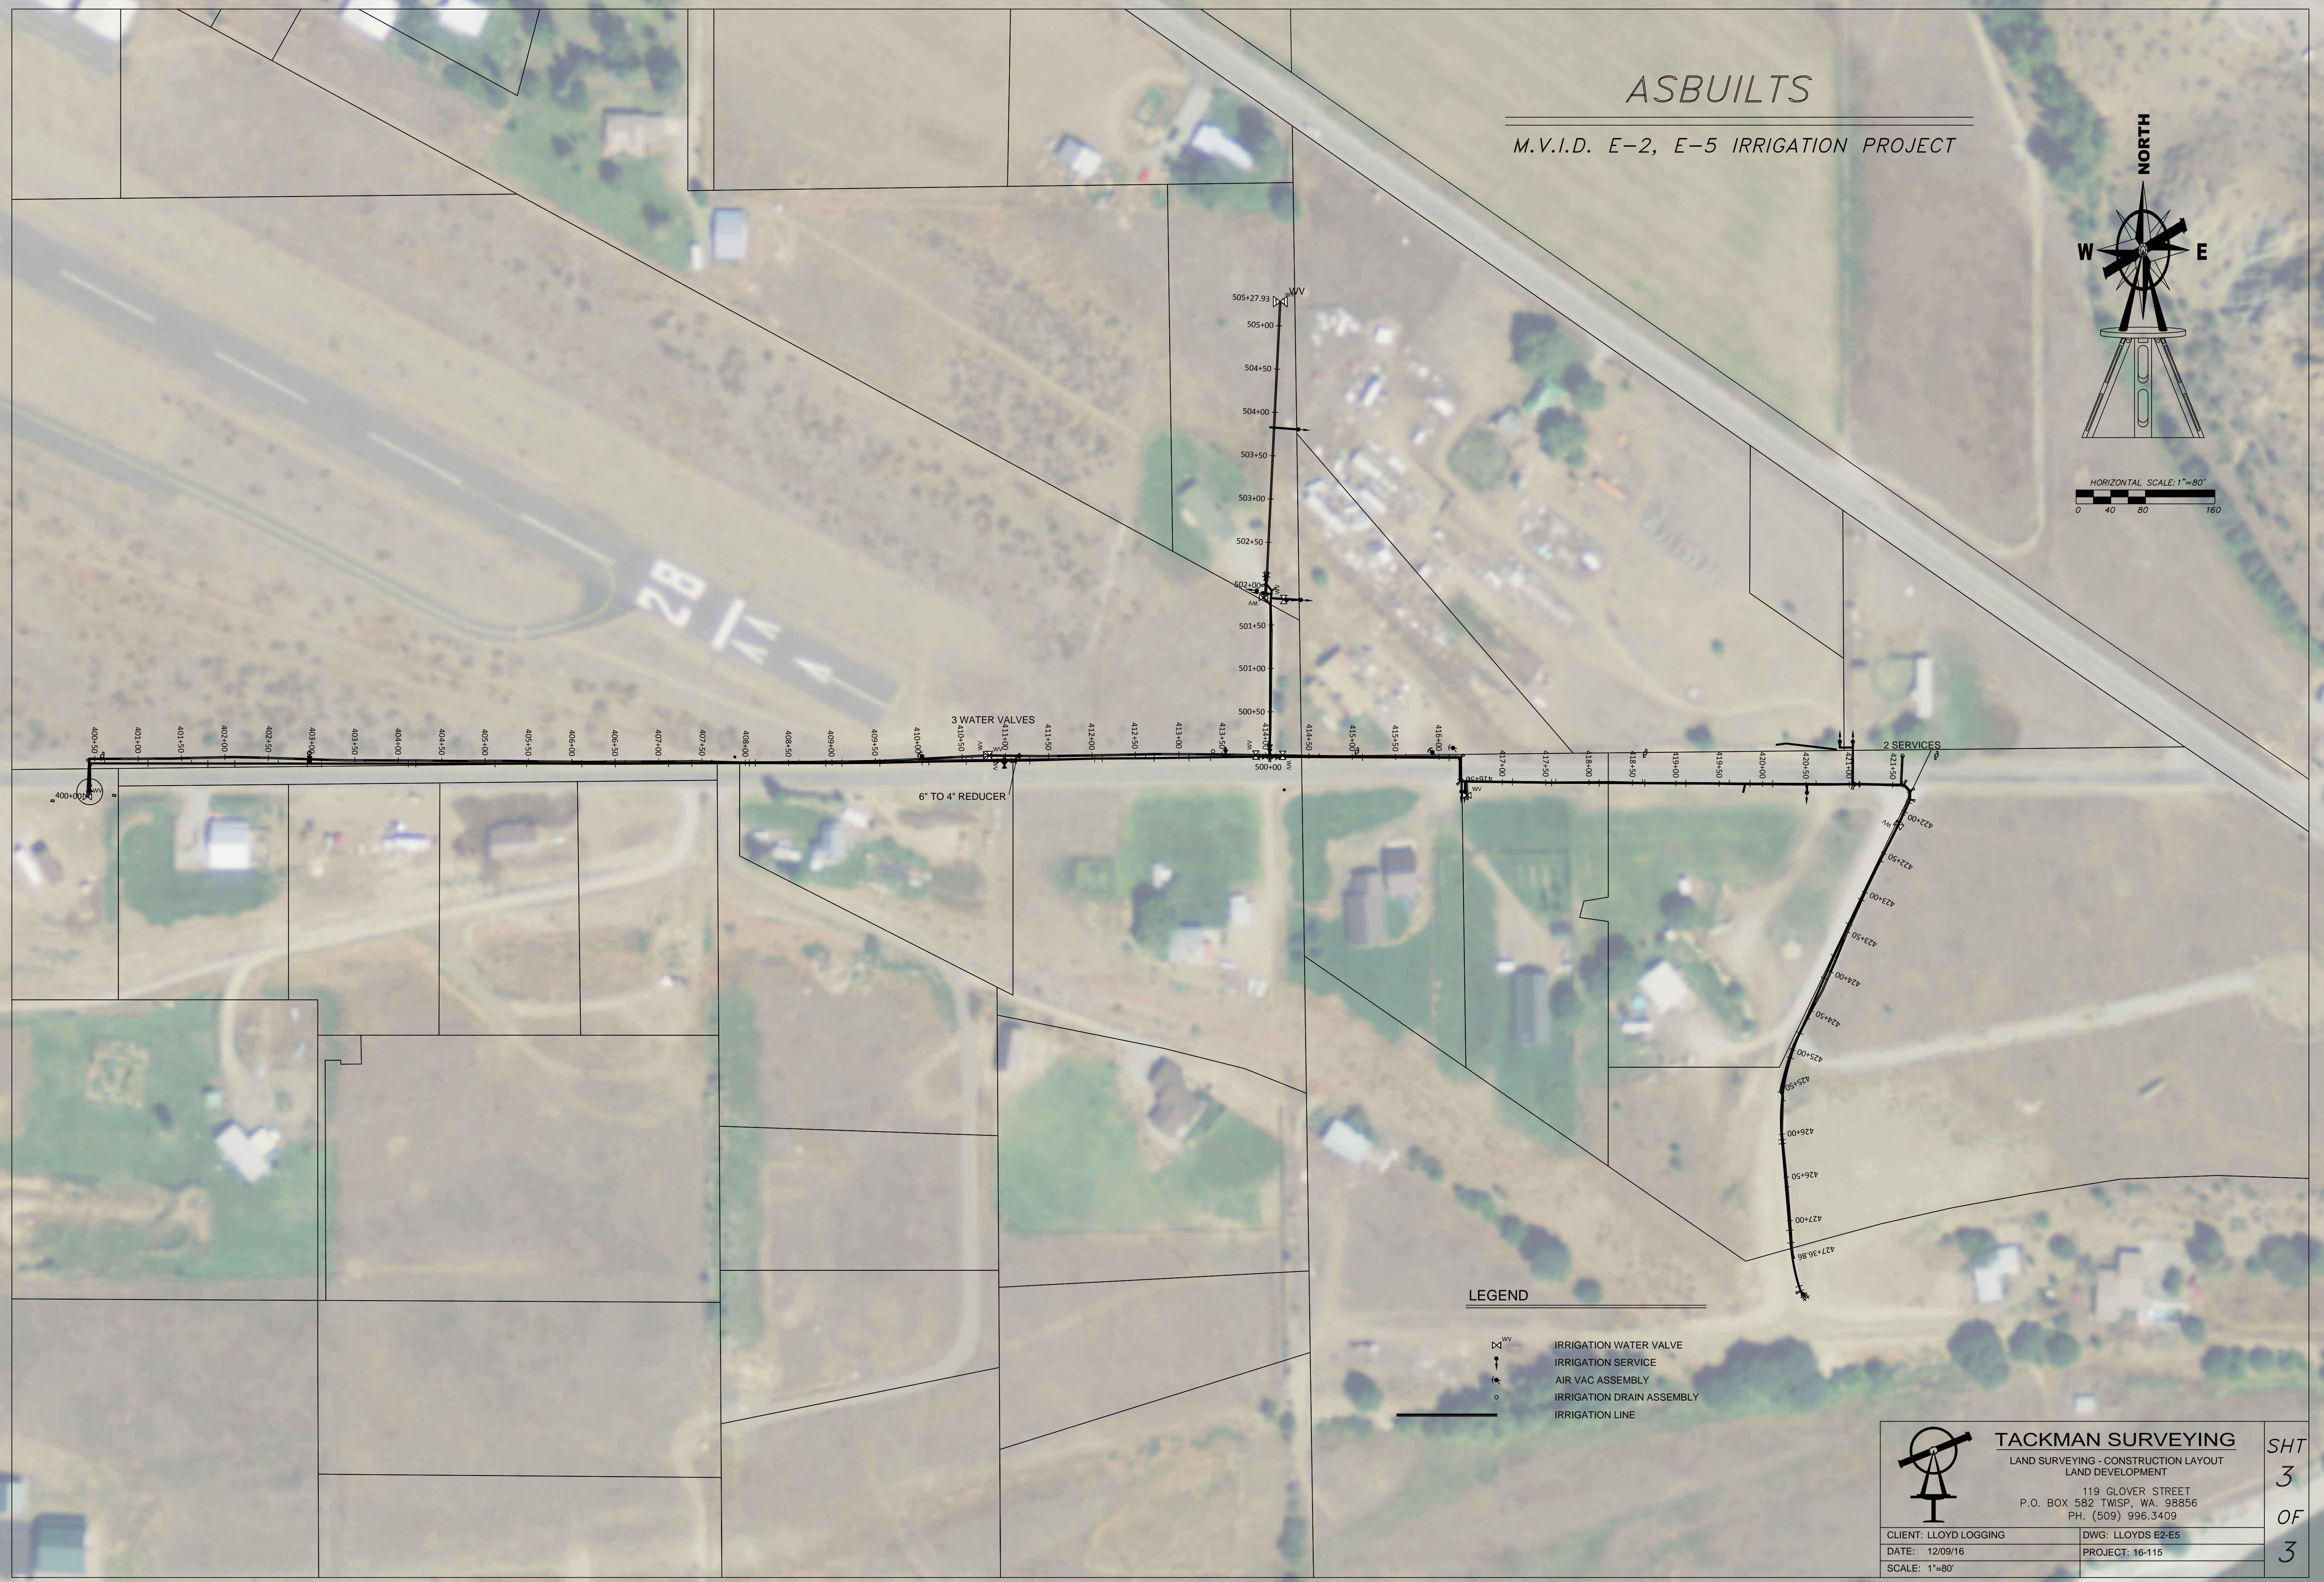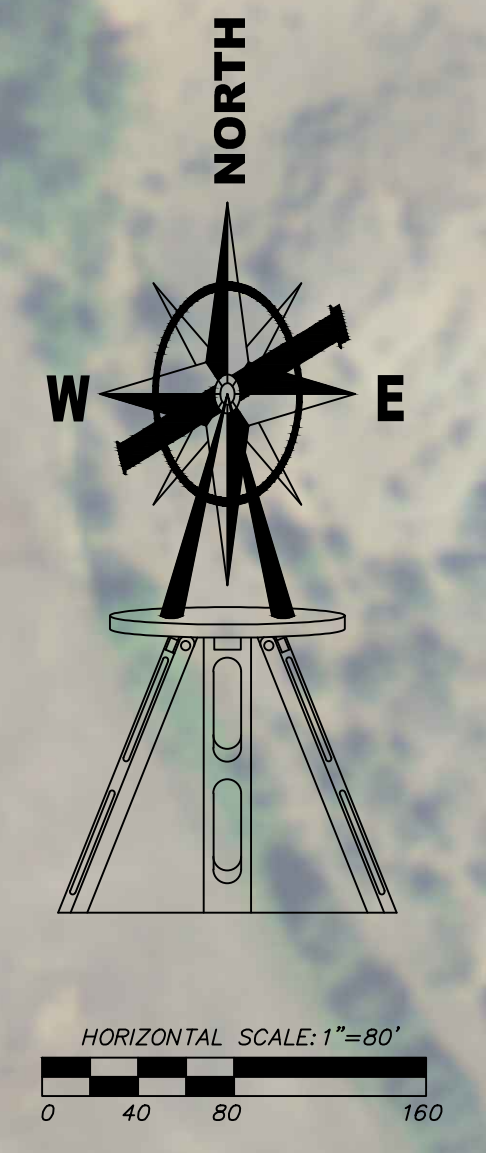

LEGEND

- IRRIGATION WATER VALVE
- IRRIGATION SERVICE
- AIR VAC ASSEMBLY
- IRRIGATION DRAIN ASSEMBLY
- IRRIGATION LINE

	TACKMAN SURVEYING LAND SURVEYING - CONSTRUCTION LAYOUT LAND DEVELOPMENT	SHT 3
	119 GLOVER STREET P.O. BOX 582 TWISP, WA. 98856 PH. (509) 996.3409	OF 3
CLIENT: LLOYD LOGGING	DWG: LLOYDS E2-E5	
DATE: 12/09/16	PROJECT: 16-115	
SCALE: 1"=80'		